


Labor and Materials

Copper } Connection.....	\$	
Lead }	\$	
Curb { Cock } 10x6 48.00	\$	48.00
{ Valve } 7.18	\$	7.18
{ T. S. & V. }	\$	56.00
Service Box } Short 3 1/2 x 4 1/2	\$	7.70
Old returned } Long 4 1/2 x 5 1/2	\$	
{ Buff. or Rdway }	\$	
20 Ft. 6 in. } Copper } Pipe at.....	\$	23.00
{ Galv. Iron }	\$	
{ Cast Iron }	\$	
Nipples..... in. at.....	\$	
Bushings..... to..... in. at.....	\$	
Red'g } Couplings..... to..... in. at.....	\$	
Inc'g }	\$	
Union..... in. at.....	\$	
Meter..... in. at.....	\$	
Lbs Br. Stone at.....	\$	
Lbs. Sand at.....	\$	
Bags Cement at.....	\$	
Paving Brick { Mack } at.....	\$	5.00
{ Red }	\$	
{ Asphalt }	\$	
4 Lead Joints at 6"	\$	3.13
1 Leadite Joints at 20"	\$	31.88
51 Hrs. Foreman at 62.05	\$	31.57
63 Hrs. Common Labor at 50	\$	8.22
20 Hrs. Common Labor at 40.90	\$	
Hrs. Mason at.....	\$	
Hrs. Mason's Helper at.....	\$	
2 Hrs. Compressor at.....	\$	4.00
Compensation Ins.....	\$	2.00
10 Trucking Time.....	\$	10.00
Builders' Use of Water. Pav. Patch	\$	57.73
Total		\$ 240.00

Labor and Material Report

6 Tap at Cox Warren Rd Ridge

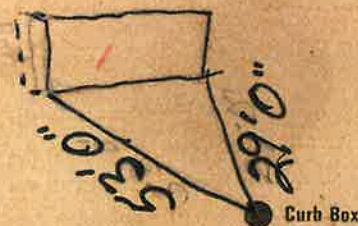

10" Main

Elev. of Main at tap 4 1/2

Gate at ●

23'6" to MAIN Gate at ●

● Curb Box