

Labor and Materials

| | | | | |
|----|------------------------|---------------------------|-------|---------|
| 1 | Copper | Connection | 2 | \$ 2.60 |
| 1 | Curb | Cock Valve P.S. & V. in. | 2 | \$ 2.30 |
| | Service Box | Short 3/4 x 1 1/2 | | |
| | Old returned | Long 4 1/2 x 5 1/2 | | \$ 1.50 |
| | | Buff. or Rdway | | |
| 34 | Ft. | Copper Galv. Iron Pipe at | 3 | \$ 9.01 |
| | Nipples | in. at | | \$ |
| | Bushings | to in. at | | \$ |
| | Red'g Inc'g | Couplings to in. at | | \$ |
| | Union | in. at | | \$ |
| | Meter | in. at | | \$ |
| | Lbs. Br. Stone | at | | \$ |
| | Lbs. Sand | at | | \$ |
| | Bags Cement | at | | \$ |
| | Paving Brick | Mack Red Asphalt at | | \$ |
| | Lead Joints | at | | \$ |
| | Leadite Joints | at | | \$ |
| 7 | Hrs. Foreman | at | 4.38 | \$ |
| 37 | Hrs. Common Labor | at | 15.03 | \$ |
| | Hrs. Common Labor | at | | \$ |
| | Hrs. Mason | at | | \$ |
| | Hrs. Mason's Helper | at | | \$ |
| 2 | Hrs. Compressor | at | 3.00 | \$ |
| | Compensation Ins. | | 51 | \$ |
| | Trucking | | 1.00 | \$ |
| | Builders' Use of Water | Patch | 25.00 | \$ |

Total \$ 64.33


29-131

Labor and Material Report

Oct 27

1979

151 Warren St.

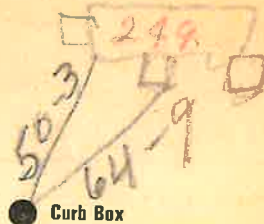

10 Main

Elev of Main at tap

Gate at ●

● Gate at

● Curb Box

all pipe disconnected

#247-#249

TAX ID # 310.6-1-25