

LABOR AND MATERIALS

1	Copper	Connection	$\frac{3}{4}$	-----	\$ 1.23	
	Lead					
1	Curb	Cock Valve T.S. & V.	$\frac{3}{4}$	in. -----	\$ 1.68	
1	Service Box	Old-returned	Short $\frac{3}{2} \times \frac{4}{2}$	} -----	\$ 1.75	
						Long $\frac{4}{2} \times \frac{5}{2}$
22	Ft. $\frac{3}{4}$ in.	Copper Galv Iron Cast-iron	Pipe at	15	\$ 3.30	
	Nipples	in. at			\$ -----	
	Bushings	to	in. at		\$ -----	
	Red'g Inc'g	Couplings	to	in. at	\$ -----	
	Union	in. at			\$ -----	
	Meter	in. at			\$ -----	
	Lead Joints	at			\$ -----	
	Leadite Joints	at			\$ -----	
	Hrs. Foreman	at			\$ -----	
2	Hrs. Chauffeur	at	$6\frac{1}{2}$		\$ 1.25	
	Hrs. Tapper	at			\$ -----	
8	Hrs. Labor	at	45		\$ 3.60	
	Hrs. Labor	at			\$ -----	
	Hrs. Compressor	at			\$ -----	
	Compensation Ins.				\$ .15	
	Trucking				\$ 1.00	
	Builders Use of Water	$\frac{1}{2}$ Patch (Sewer)			\$ 2.50	
	Tap by 7.000"				\$ -----	
					\$ -----	
					\$ -----	
					\$ -----	
					\$ 16.46	

48 - 1938

St. 252 256  
Pl. -----  
Ave. No. 159


Wattson

Name of Owner

Caputo

Labor and Mat'l. Report

July 29 1938

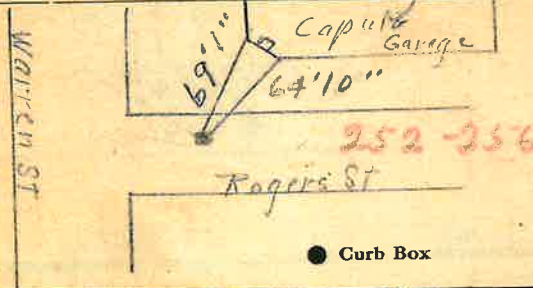

#254 TAX ID# 303.18-18-1

6 Main Elev. of Main at tap  $4\frac{1}{2}$

Gate at ● Gate at ●

$\frac{3}{4}$ " Copper 22' to main

● Curb Box

New Tap

This Curb Stop is off  
When ON ~~off~~ Position  
ON