


3/4" copper 39' to main

Gate at ● Gate at ●
Main at tap Main
Elev. of 10" Main at tap 5 1/2"

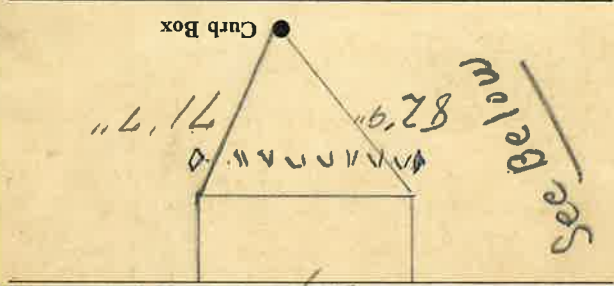


Labor and Mat'l. Report April-11 1952

Name of Owner Rist + Frost Assoc Consulting Engineers

Warren Ave. No. 259 St. Pl.


St. Pl. Warren Ave. No. 259
Name of Owner Rist + Frost Assoc Consulting Engineers

Labor and Mat'l. Report April-11 1952

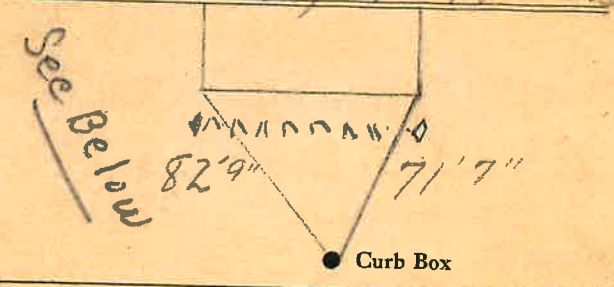

10" Main Elev. of Main at tap 5 1/2"
Gate at ● Gate at ●

3/4" copper 39' to main

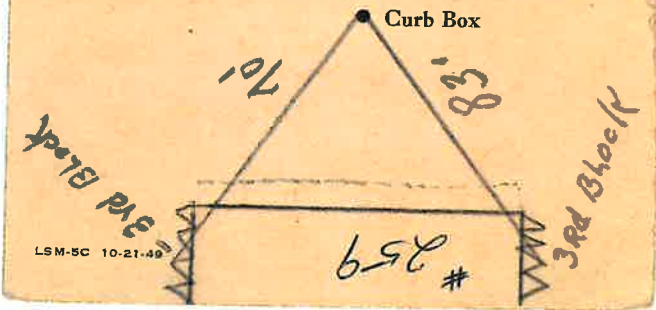

LABOR AND MATERIALS

1	Copper	{	Connection	3/4"			
	Lead	}				\$	2.76
1	Curb	{	Cock Valve	3/4" in.		\$	3.49
		}	T.S. & V.				
1	Service box	{	Short 3 1/2 x 4 1/2			\$	4.75
	Old returned	}	Long 4 1/2 x 5 1/2				
			Buff. or Rdway				
39	Ft. 3/4" in.	{	Copper		Pipe at 35	\$	13.65
		}	G.I.				
			C.I.				
	Nipples		in. at			\$	
	Bushings		to in. at			\$	
	Red'g	{	Coupl'gs	to in. at		\$	
	Inc'g	}					
	Union		in. at			\$	
	Meter		in. at			\$	
	Lead Joints		at			\$	
8	Compound Joints		at	1.44		\$	11.52
11	Hrs. Water Maint. Man-1		at	1.34		\$	14.74
9	Hrs. Water Maint. Man-2		at	1.24		\$	11.16
1	Hrs. Labor		at			\$	1.52
68	Hrs. Labor		at	1.13		\$	76.84
3	Hrs. Compressor		at	1.50		\$	4.50
	Compensation Ins.		at \$3.106 per C.			\$	4.29
	Trucking					\$	1.50
	Pav't Patch					\$	25.70
	O'head					\$	
						\$	175.42

Top made by Warsinski
& Gifford 4-21-52