


Warren St. Ave. No. 260

Name of Owner L.R.D. Thrifty Laundromat

Labor and Mat'l. Report Oct. 1 1958

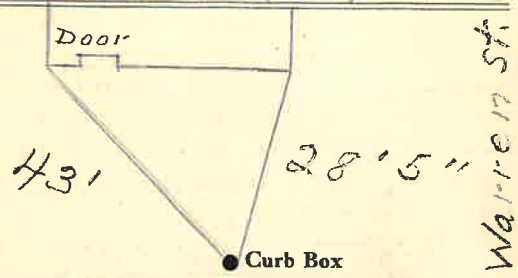

6" Main Rogers St. Elev. of Main at tap 3 1/2"

Gate at 1 1/2" copper 25' to main

Curb Box


1 1/2" Tap, on Rogers St.

LSM-5C-2-5-56

Warren St. Ave. No. 260

Name of Owner TAX ID # 303.18-15-17

Labor and Mat'l. Report Nov. 7 1952

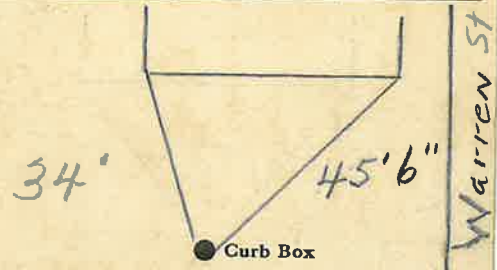

6" Main Rogers St. Elev. of Main at tap 4'

Gate at 3/4" copper 27' to main

Curb Box

Tap on Rogers St. 3/4" shut off at main 3-15-81 By Lynch

LSM-5C B 1B-48

### LABOR AND MATERIALS

1	Copper Lead	Connection	1 1/2"	\$	
1	Curb	Cock Valve T. S. & V.	1 1/2 in.	\$	
1	Service box	Short 3 1/2 x 4 1/2 Long 4 1/2 x 5 1/2 Buff or Rdway		\$	
	Old returned			\$	
25	Ft. 1 1/2 in.		Copper G.I. C.I. } Pipe at		\$
	Nipples	in. at		\$	
	Bushings	to in. at		\$	
	Red'g Inc'g	Coupl'gs	to in. at	\$	
	Union		in. at	\$	
	Meter	in. at	\$		
	Lead Joints	at	\$		
	Compound Joints	at	\$		
	Maintenance Foreman		\$		
	Hrs. Water Maint. Man-1	at	\$		
	Hrs. Water Maint. Man-2	at	\$		
	Hrs. Garage Foreman	at	\$		
	Hrs. Labor	at	\$		
	Hrs. Compressor	at	\$		
	Compensation Ins. at \$	per C	\$		
	Trucking		\$		
	Pav't Patch		\$		
	Tap by Lareau + Peter-son		\$		
		10-1-58.	\$		
	O'head		\$		
			\$		

### LABOR AND MATERIALS

1	Copper Lead	Connection	3/4"	\$	2.76
1	Curb	Cock Valve T. S. & V.	3/4 in.	\$	3.49
1	Service box	Short 3 1/2 X 4 1/2 Long 4 1/2 X 5 1/2 Buff or Rdway		\$	4.74
	Old returned			\$	
27	Ft. 3/4 in.		Copper G.I. C.I. } Pipe at	35	\$
	Nipples	in. at		\$	
	Bushings	to in. at		\$	
	Red'g Inc'g	Coupl'gs	to in. at	\$	
	Union		in. at	\$	
	Meter	in. at	\$		
	Lead Joints	at	\$		
	Compound Joints	at	\$		
	Hrs. Water Maint. Man-1	at	\$		
3	Hrs. Water Maint. Man-2	at	1.24	\$	3.72
14	Hrs. Labor	at	1.13	\$	15.82
	Hrs. Labor	at		\$	
	Hrs. Compressor	at		\$	
	Compensation Ins. at \$	3.106 per C		\$	7.2
	Trucking			\$	1.00
	Pav't Patch			\$	16.54
	Tap by Giggord		11-7-52	\$	
				\$	
	O'head			\$	
				\$	58.24

4170