

Fit to main 14'


LABOR AND MATERIALS

- Copper } Connection _____ \$ _____
- Lead } _____ \$ _____
- Curb } Cock _____ in. _____ \$ _____
- } Valve _____
- } T.S. & V. _____
- Service box { Short 3-1/2 x 4-1/2 } _____ \$ _____
- Old returned { Long 4-1/2 x 5-1/2 } _____ \$ _____
- Ft. _____ in. Copper } Pipe at _____ \$ _____
- } G.I. _____
- } C.I. _____
- Nipples _____ in. at _____ \$ _____
- Bushings _____ to _____ in. at _____ \$ _____
- Red'g _____
- Inc'g _____
- Union _____ in. at _____ \$ _____
- Meter _____ in. at _____ \$ _____
- _____ \$ _____
- Compound Joints at _____ \$ _____
- Maintenance Foreman _____ \$ _____
- Hrs. Water Maint. Man - 1 at _____ \$ _____
- Hrs. Water Maint. Man - 2 at _____ \$ _____
- Hrs. Garage Foreman _____ at _____ \$ _____
- Hrs. Labor _____ at _____ \$ _____
- Hrs. Compressor at _____ \$ _____
- _____ \$ _____
- Trucking _____ \$ _____
- Pav't Patch _____ \$ _____
- _____ \$ _____
- _____ \$ _____
Warren St St
Pl. Ave. No. 264

Name of Owner _____

Labor and Mat'l. Report 19 _____

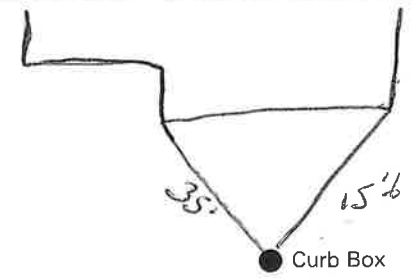

_____ Main Elev. of
Main at tap _____

Gate at ● ● Gate at

TAX ID # 303.18-15-17

● Curb Box