


LABOR AND MATERIALS

1	Copper	Connection	3/4"	\$
1	Lead	Cock		
1	Curb	Valve	3/4 in.	\$
		T. S. & V.		
1	Service box	Short 3 1/2 x 4 1/2		
	Old returned	Long 4 1/2 x 5 1/2		
		Buff or Rdway		\$
11	Ft. 3/4 in.	Copper	Pipe at	\$
		G. I.		
		G. I.		
	Nipples	in. at		\$
	Bushings	to in. at		\$
	Red'g			
	Inc'g	Coupl'gs. to in. at		\$
	Union	in. at		\$
	Meter	in. at		\$
	Lead Joints at			\$
	Compound Joints at			\$
	Maintenance Foreman			\$
	Hrs. Water Maint. Man-1 at			\$
	Hrs. Water Maint. Man-2 at			\$
	Hrs. Garage Foreman at			\$
	Hrs. Labor at			\$
	Hrs. Compressor at			\$
	Compensation Ins. at \$	per C		\$
	Trucking			\$
	Pav't Patch			\$
	Top by Gifford & Co.			\$
	5-9-58			\$
	O'head			\$
				\$

Warren St. Ave. No. 266

Name of Owner
TAX ID # 303.18-15-18

Labor and Mat'l. Report May 9 1958

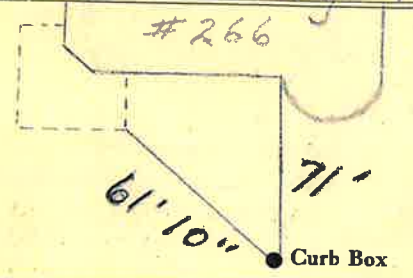

8" Main Elev. of Main at tap 6'

Gate at Gate at
3/4" Copper 11' to main

● Curb Box