

64 34

Labor and Material Report Apr 10 1932

3/4" tap at 1634 1/2 Warren st



9" Main

Elev. of Main at tap 6.6 ft

Gate at ● Gate at ●

3/4" copper 34' to main

● Curb Box

New tap

TAX ID #

to be changed.

HH


1/4

Warren St

St. 267-269  
Pl. 161-163  
Ave. No.

Name of Owner

Labor and Mat'l. Report Oct 23 1945

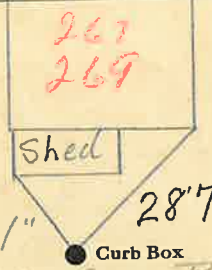

Measure from Rear of House

Main Elev. of Main at tap

Gate at ● Gate at ●

#269 TAX ID # 310.6-1-15

● Curb Box

House Razed

Notice  
Water come in Back of House


LSM-5C-6-1-45



Warren St. St. Pl. Ave. No. 267

Name of Owner Henry Caputo

Labor and Mat'l. Report April 12 19 60

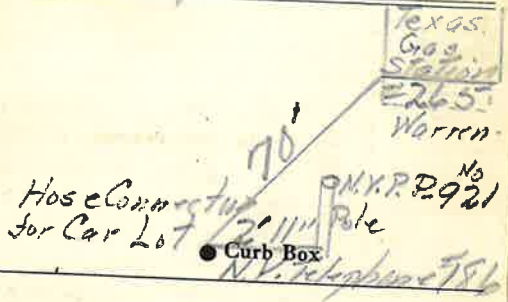

8" Main Elev. of Main at tap 5 1/2'

Gate at 3/4" Copper 39' to MAIN


Curb Box

LSM-5C-2-5 56

Rear St. Pl. Ave. No. 267 16 1/2

Warren St. Name of Owner Plaza Lumber Co Inc

Was Wood Flour Mill Labor and Mat'l. Report June 16 1943

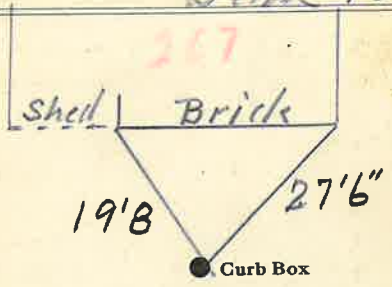

3" Main Elev. of Main at tap 5'

Gate at

(LA. Rose)

Two of La Rose's Bldg. are feed by a 4" line that is tapped on Warren St at Roger - see Gate Bk

