

WARREN

St.

WARREN

No. 269R



Name of Owner

JOINTA GALUSHA - CONCRETE PLANT

Labor and Mat'l. Report

BARRICADE

1999

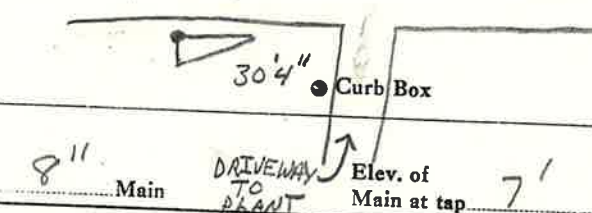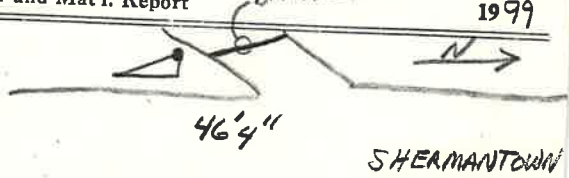

Gate at ●

● Gate at

4" Copper

● Curb Box

TAP ON SHEARMANTOWN RD.

TAX ID # 310.6-1-28

LSM-5C-6-1-67

WARREN

St.

WARREN

No. 269R



Name of Owner

JOINTA GALUSHA - CONCRETE PLANT

Labor and Mat'l. Report

BARRICADE

1999

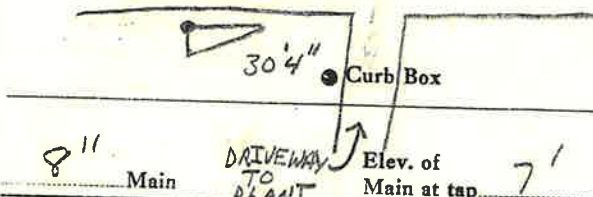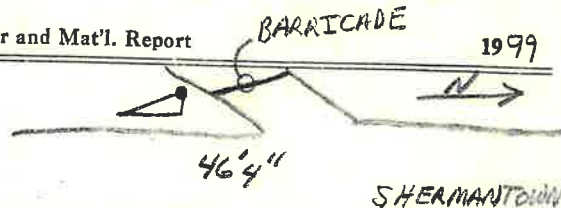

Gate at ●

● Gate at

4" Copper

● Curb Box

TAP ON SHEARMANTOWN RD.

TAX ID # 310.6-1-28

LSM-5C-6-1-67