

**Labor and Materials**

1	Copper	Lead	Connection	3/4"	\$ 3.20
1	Curb	Cock Valve	T.S. & V.	3/4" in.	\$ 1.00
1	Service Box	Old returned	Short 3 1/2 x 4 1/2 Long 4 1/2 x 5 1/2 Buff. or Rdway		\$ 1.30
2.7	Pt. 3/4"		Copper Galv. Iron Cast Iron	Pipe at.	\$ 5.94
	Nipples			in. at.	\$
	Bushings			to.....in. at.	\$
	Red'g Inc'g	Couplings		to.....in. at.	\$
	Union			in. at.	\$
	Meter			in. at.	\$
	Lbs. Br. Stone			at.	\$
	Lbs. Sand			at.	\$
	Bags Cement			at.	\$
	Paving Brick	Mack Red Asphalt		at.	\$
	Lead Joints			at.	\$
	Leadite Joints			at.	\$
9	Hrs. Foreman			at.	\$ 56.3
2	Hrs. Common Labor			at.	\$ 1.00
47	Hrs. Common Labor			at.	\$ 19.09
	Hrs. Mason			at.	\$
	Hrs. Mason's Helper			at.	\$
	Hrs. Compressor			at.	\$
	Compensation Ins.				\$ 6.8
	Trucking				\$ 1.00
	Builders' Use of Water				\$


Total \$ 38.84

27-211

Labor and Material Report *Nov 15-17* 19 27

162 Warren St

272

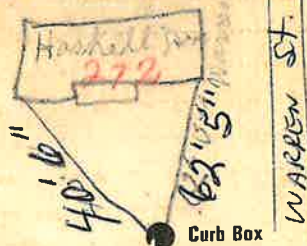

TAX ID# 303.18-16-3

6" Main Elev. of Main at tap 4 1/2

Gate at 3/4" Copper 27 to MAIN Gate at

Old shed off Curb Box