


LABOR AND MATERIALS

1	Copper	}	Connection		\$	
	Lead					
1	Curb	}	Cock	in.	\$	
			Valve			
			T.S. & V.			
1	Service box	}	Short 3 1/2 x 4 1/2		\$	
	Old returned		Long 4 1/2 x 5 1/2			
			Buff or Rdway			
32	Ft.	}	Copper	Pipe at	\$	
	3/4 in.		Gal.			
	Nipples		in.	at	\$	
	Bushings		to	in. at	\$	
1	Red'g	}	Coupl'gs	3/4 to in.	at	\$
	Ins.					
	Union		in.	at	\$	
	Meter		in.	at	\$	
	Lead Joints at				\$	
	Compound Joints at				\$	
	Maintenance Foreman				\$	
	Hrs. Water Maint. Man-1 at				\$	
	Hrs. Water Maint. Man-2 at				\$	
	Hrs. Garage Foreman at				\$	
	Hrs. Labor— at				\$	
	Hrs. Compressor at				\$	
	Compensation Ins. at \$		per C		\$	
	Trucking				\$	
	Pav't Patch				\$	
					\$	
					\$	
	O'head				\$	

St. 277
~~Pl.~~ Ave. No.

Name of Owner
HOFFIS

Labor and Mat'l. Report 19

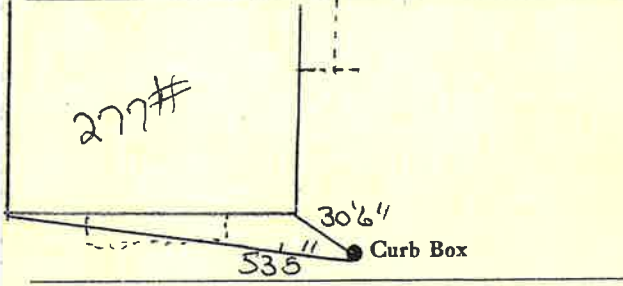

6 Main Elev. of Main at tap 6"

Gate at • • Gate at
3/4" copper 32' to main

• Curb Box

TAX ID # 310.6-1-13