


LABOR AND MATERIALS

1	Copper	} Connection	3/4"	\$
	Lead			
1	Curb	} 3/4 in. or seal		\$
	Cock			
	Valve			
		T. S. & V.		\$
1	Service box	} { Short 3 1/2 x 4 1/2 Long 4 1/2 x 5 1/2 Buff. or Rdway }		\$
	Old returned			
160	Ft. 3/4 in.	} Pipe at		\$
			Copper	
			G.I.	
		C.I.		\$
	Nipples	in. at		\$
	Bushings	to in. at		\$
	Red'g	} Coupl'gs	to in. at	\$
	Inc'g			
	Union	in. at		\$
	Meter	in. at		\$
	Lead Joints	at		\$
	Compound Joints	at		\$
	Maintenance Foreman			\$
	Hrs. Water Maint. Man-1	at		\$
	Hrs. Water Maint. Man-2	at		\$
	Hrs. Garage Foreman	at		\$
	Hrs. Labor	at		\$
	Hrs. Compressor	at		\$
	Compensation Ins. at \$	per C		\$
	Trucking			\$
	Pav't Patch			\$
	Tap by Gierard			\$
	10-23-63			\$
	O'head			\$

St. Warren
Pt. Ave. No. 280

Name of Owner
Sharon Deeb

Labor and Mat'l. Report Oct. 23, 1965

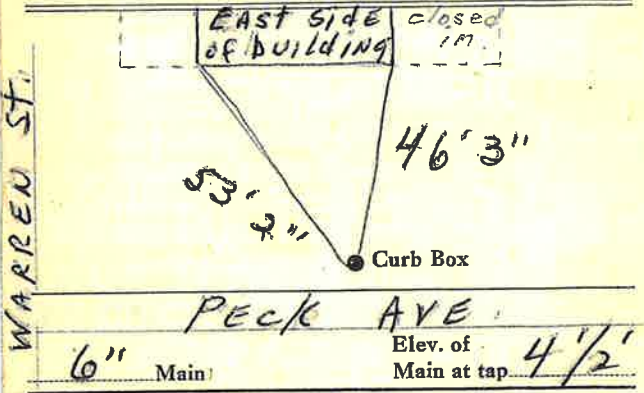

6" Main Elev. of Main at tap 4 1/2'

Gate at • Gate at

3/4" Copper 16' to MAIN

• Curb Box

TAX ID# 303.18-16-6