


Labor and Materials

Copper } Connection..... 3	\$ 3.20
Lead }	
Curb } Cock Valve }	\$ 1.00
} T. S. & V. }	
Service Box } Short 3' x 4' }	\$ 1.40
Old returned } Long 4' x 5' }	
} Built on Rdway }	
4 Ft. in. } Copper Galv. Iron } Pipe at..... 3	\$ 1.88
} Cast Iron }	
Nipples..... in. at..... 4	\$
Bushings..... to..... in. at.....	\$
Red'g } Couplings..... to..... in. at.....	\$
Inc'g }	
Union..... in. at.....	\$
Meter..... in. at.....	\$
Lbs. Br. Stone at.....	\$
Lbs. Sand at.....	\$
Bags Cement at.....	\$
Paving Brick } Mack Red } at.....	\$
} Asphalt }	
Lead Joints at.....	\$
Leadite Joints at.....	\$
6 Hrs. Foreman at..... 6.25	\$ 3.75
21 Hrs. Common Labor at..... 50	\$ 10.50
..... Hrs. Common Labor at.....	\$
..... Hrs. Mason at.....	\$
..... Hrs. Mason's Helper at.....	\$
2 Hrs. Compressor at.....	\$ 4.00
Compensation Ins.....	\$.38
Trucking.....	\$ 1.22
Builders' Use of Water.....	\$
Total \$27.31	

Labor and Material Report

Sept 25 1926

170 Warren St

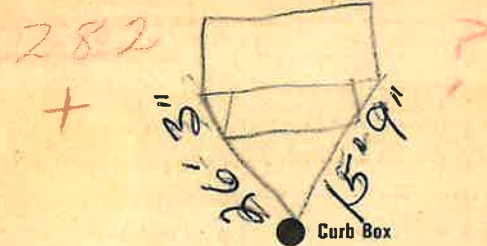

6 Main Elev. of Main at tap 6
 Gate at ● Gate at ●
 9' to MAIN

New York

10/22
 Part of #280 on map