


**Labor and Materials**

1	Copper	} Connection. $\frac{3}{4}$ "	.....	\$ 1.48
1	Lead			
1	Curb	} $\frac{3}{4}$ " in	.....	\$ 1.79
	Cock Valve T.S. & V.			
1	Service Box	} Short $3\frac{1}{2} \times 4\frac{1}{2}$ Long $4\frac{1}{2} \times 5\frac{1}{2}$ Buff. or Rdway	.....	\$ 1.30
	Old returned			
35	Ft. $\frac{3}{4}$ " in.	} Copper Galv. Iron Cast Iron	Pipe at .....	\$ 5.33
	Nipples .....			
	Rushings .....	to .....	in. at .....	\$ .....
	Red'g Inc'g	} Couplings .....	to .....	in. at .....
	Union .....			
	Meter .....	in. at .....	\$ .....	
	Lbs. Br. Stone at .....	\$ .....		
	Lbs. Sand at .....	\$ .....		
	Bags Cement at .....	\$ .....		
	Paving Brick	} Mack Red Asphalt	at .....	\$ .....
	Lead Joints at .....			
	Leadite Joints at .....	\$ .....		
11	Hrs. Foreman at .....	\$ 6.88		
11	Hrs. Common Labor at .....	\$ 2.58		
11	Hrs. Common Labor at .....	\$ 4.24		
	Hrs. Mason at .....	\$ .....		
	Hrs. Masons Helper at .....	\$ .....		
4	Hrs. Compressor at .....	\$ 3.30		
	Compensation Ins .....	\$ 0.53		
	Trucking .....	\$ 2.00		
	Builders Use of Water <i>Per. Rate</i> .....	\$ 18.-		
Total \$ .....				

*3/4" Renewed At 197*

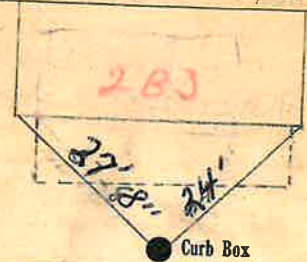

TAX ID# 310.6-1-10

6" Main Elev. of Main at tap 7

Gate at  $\frac{3}{4}$ " copper Gate at 35' to MAIN

● Curb Box

*Old tap shut off*

*Pipe was old had leak was renewed by Dept.*

*No application made out by owner.*

*P.L.G. J.H.H.*