


11 7-1937

Warren

St. ~~Pl.~~ 59-65
Ave. No. 33 or 35

Name of Owner
St Mary Church

Labor and Mat'l. Report Sept 16 1937

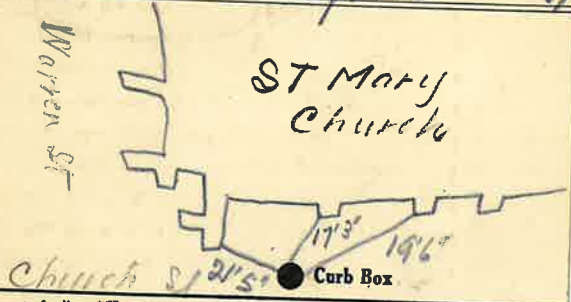

Church St 21'5" ● Curb Box
1 1/2" Tap on Church St.
4 6" Main Elev. of Main at tap 4'11"

Gate at ● Gate at


● Curb Box
old shut off
Hb

65

Warren St

St. ~~Pl.~~ 59-65
Ave. No. 33-35

Name of Owner
This service is between
ST Mary Church HbSt. office
Labor and Mat'l. Report Dec 9 46 19

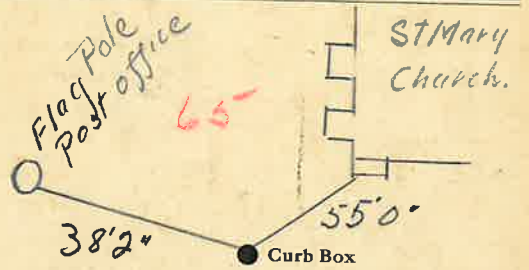

Main Elev. of Main at tap
Gate at ● # 59-65 Gate at

TAX ID# 310.5-2-4

● Curb Box

Shut off at Curb & Curb Box
taken out

LSM-SC-6-1-45

