

LABOR AND MATERIALS


Copper	} Connection _____	\$ _____			
Lead					
Curb	} Cock Valve T. S. & V. } _____ in.	\$ _____			
			Service box	} Short 3½ x 4½ Long 4½ x 5½ Buff or Rdway } _____	\$ _____
Ft. _____ in.	} Copper G. I. C. I. } Pipe at _____	\$ _____			
Nipples _____ in. at _____					
Bushings _____ to _____ in. at _____					
Red'g } Inc'g }	} Coupl'gs _____ to _____ in. at _____	\$ _____			
Union _____ in. at _____					
Meter _____ in. at _____		\$ _____			
Lead Joints at _____		\$ _____			
Compound Joints at _____		\$ _____			
Maintenance Foreman _____		\$ _____			
Hrs. Water Maint. Man—1 at _____		\$ _____			
Hrs. Water Maint. Man—2 at _____		\$ _____			
Hrs. Garage Foreman _____ at _____		\$ _____			
Hrs. Labor— _____ at _____		\$ _____			
Hrs. Compressor at _____		\$ _____			
Compensation Ins. at \$ _____ per C _____		\$ _____			
Trucking _____		\$ _____			
Pav't Patch _____		\$ _____			
_____		\$ _____			
_____		\$ _____			
O'head _____		\$ _____			
_____		\$ _____			

St. _____
Pl. _____
Ave. No. 68

Warren
Name of Owner

GENPAK CORP.
CLD KC

Labor and Mat'l. Report 19

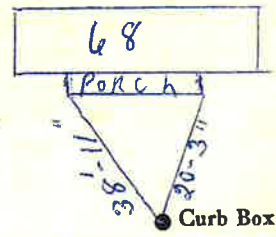

WARREN ST

10' Main Elev. of Main at tap 4'

Gate at • • Gate at

• Curb Box

TAX ID# 303.17-179