


WARREN ST. St. Ave. No. 80-82

Name of Owner
#80 TAX ID # 303.17-18-19


Labor and Mat'l. Report ~~49~~ 2006

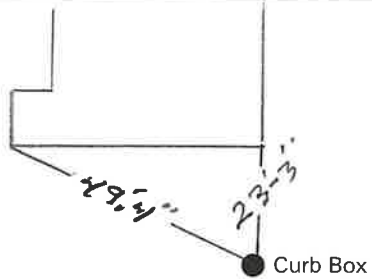


16 Main Elev. of Main at tap 5
Gate at ● Gate at ●

● Curb Box


135 80-82
Labor and Material Report Nov. 10 1936

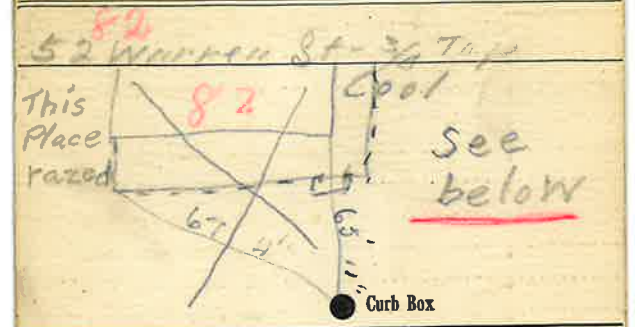

10 Main 12' to main Elev. of Main at tap 5
Gate at ● Gate at ●

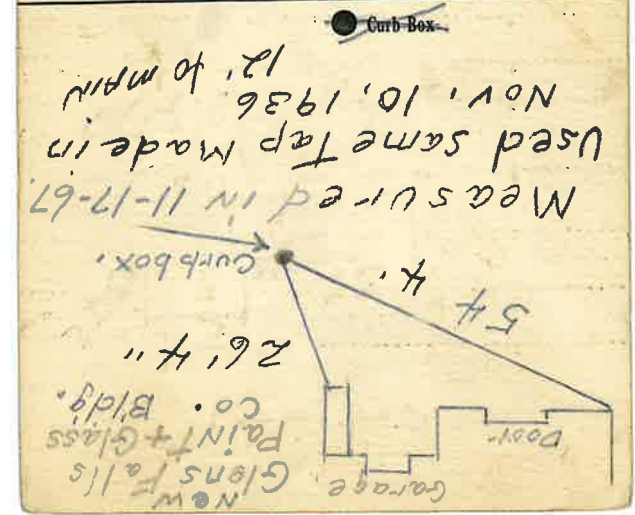

MEASURED IN 11-17-67
Used same tap made in
Nov. 10, 1936
12' to main

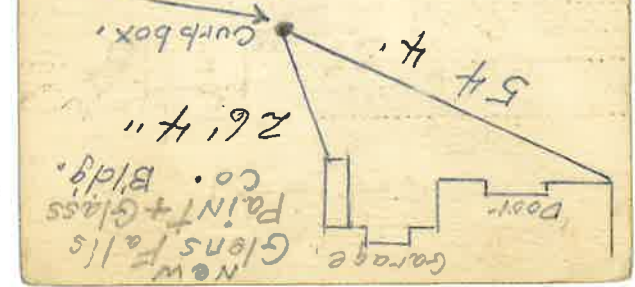


LABOR AND MATERIALS

_____	Copper } Connection _____	\$ _____
_____	Lead } _____	\$ _____
_____	Curb { Cock Valve } _____ in. _____	\$ _____
	T.S. & V. } _____	
_____	Service box { Short 3-1/2 x 4-1/2 } _____	\$ _____
_____	Old returned { Long 4-1/2 x 5-1/2 } _____	\$ _____
_____	Ft. _____ in. { Copper G.I. } Pipe at _____	\$ _____
_____	C.I. } _____	
_____	Nipples _____ in. at _____	\$ _____
_____	Bushings _____ to _____ in. at _____	\$ _____
_____	Red'g _____	\$ _____
_____	Inc'g _____	\$ _____
_____	Union _____ in. at _____	\$ _____
_____	Meter _____ in. at _____	\$ _____
_____	_____	\$ _____
_____	Compound Joints at _____	\$ _____
_____	Maintenance Foreman _____	\$ _____
_____	Hrs. Water Maint. Man - 1 at _____	\$ _____
_____	Hrs. Water Maint. Man - 2 at _____	\$ _____
_____	Hrs. Garage Foreman _____ at _____	\$ _____
_____	Hrs. Labor _____ at _____	\$ _____
_____	Hrs. Compressor at _____	\$ _____
_____	_____	\$ _____
_____	Trucking _____	\$ _____
_____	Pav't Patch _____	\$ _____
_____	_____	\$ _____
_____	_____	\$ _____
Labor and Materials

1	Copper } Connection <u>3/4</u>	\$ <u>1.96</u>
	Lead } _____	\$ _____
1	Curb { Cock Valve } <u>3/4</u> in. _____	\$ <u>1.33</u>
	T.S.&V. } _____	
1	Service Box { Short 3 1/2 x 4 1/2 } _____	\$ <u>1.35</u>
	Old returned { Long 4 1/2 x 5 1/2 } _____	\$ _____
	Buff. or Rdwy. } _____	
12	Ft. <u>3 1/2</u> in. { Copper Galv. Iron } Pipe at <u>15</u>	\$ <u>1.80</u>
	Cast Iron } _____	
_____	Nipples _____ in. at _____	\$ _____
_____	Bushings _____ to _____ in. at _____	\$ _____
_____	Red'g } Couplings _____ to _____ in. at _____	\$ _____
	Inc'g } _____	
_____	Union _____ in. at _____	\$ _____
_____	Meter _____ in. at _____	\$ _____
_____	Lbs. Br. Stone at _____	\$ _____
_____	Lbs. Sand at _____	\$ _____
_____	Bags Cement at _____	\$ _____
_____	Paving Brick { Mack Red } at _____	\$ _____
	Asphalt } _____	
_____	Lead Joints at _____	\$ _____
_____	Leadite Joints at _____	\$ _____
_____	Hrs. Foreman at _____	\$ _____
_____	Hrs. Common Labor at _____	\$ _____
_____	Hrs. Common Labor at _____	\$ _____
_____	Hrs. Mason at _____	\$ _____
_____	Hrs. Masons Helper at _____	\$ _____
_____	Hrs. Compressor at _____	\$ _____
_____	Compensation Ins _____	\$ _____
_____	Trucking _____	\$ _____
_____	Builders Use of Water _____	\$ _____
Total \$		\$ _____

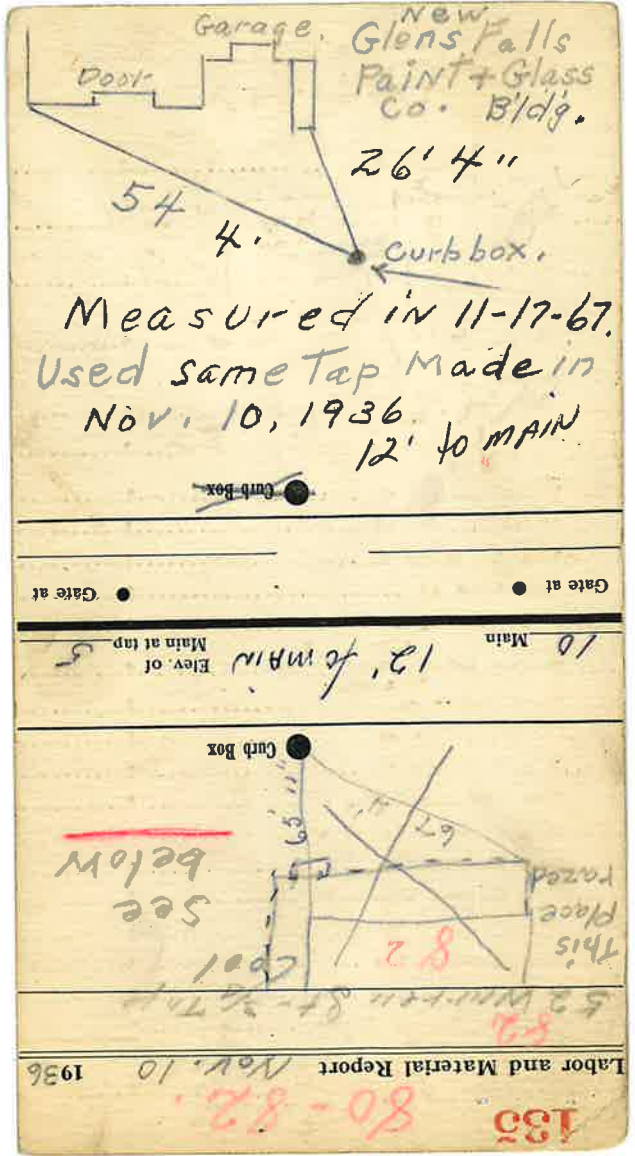


Garage
Door
New Glens Falls
Paint + Glass
Co. Bldg.
26' 4"
54 4"
curb box.

Measured in 11-17-67.
Used same Tap Made in
Nov. 10, 1936.
12' to main

Gate at ●
Curb Box ●

10 Main
Elev. of 12' to main
Main at tap 5

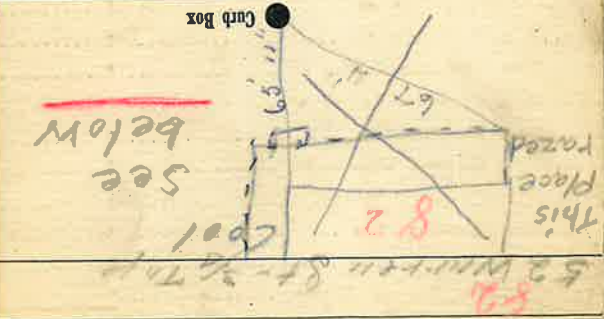

130
80-82.
Nov. 10 1936
Labor and Material Report
52 written 8-26-71
This place razed
67
68
See below