


St. WARREN
Pt. 88
Ave. No. 88
Name of Owner

TAX ID # 303.17-18-20

Labor and Mat'l. Report ~~49~~ 2006

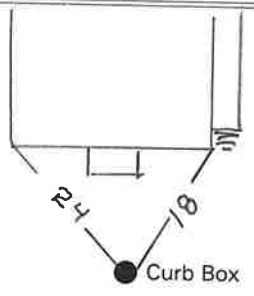


16 Main Elev. of Main at tap 5
Gate at ● Gate at ●

● Curb Box

14 1941
St. Warren
Pt. 88
Ave. No. 54
Name of Owner

Rose

Labor and Mat'l. Report Sept 19 1941

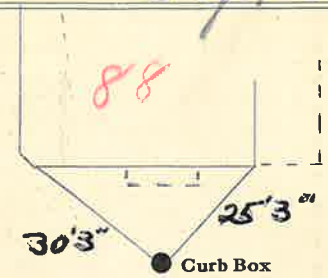

10 Main Elev. of Main at tap 5
Gate at ● Gate at ●

10' to MAIN
● Curb Box

LABOR AND MATERIALS


_____	Copper	_____	Connection	_____	\$	_____
_____	Lead	_____		_____	\$	_____
_____	Curb	_____	Cock Valve T.S. & V. } _____	in.	\$	_____

_____	Service box	_____	Short 3-1/2 x 4-1/2	_____	\$	_____
_____	Old returned	_____	Long 4-1/2 x 5-1/2	_____	\$	_____
_____	Ft. _____	in. _____	Copper G.I. C.I. } Pipe at	_____	\$	_____
_____	Nipples	_____		in. at	_____	\$
_____	Bushings	_____	to _____	in. at	\$	_____
_____	Red'g	_____			\$	_____
_____	Inc'g	_____			\$	_____
_____	Union	_____	in. at	_____	\$	_____
_____	Meter	_____	in. at	_____	\$	_____
_____		_____			\$	_____
_____	Compound Joints at	_____			\$	_____
_____	Maintenance Foreman	_____			\$	_____
_____	Hrs. Water Maint. Man - 1 at	_____			\$	_____
_____	Hrs. Water Maint. Man - 2 at	_____			\$	_____
_____	Hrs. Garage Foreman	_____	at	_____	\$	_____
_____	Hrs. Labor	_____	at	_____	\$	_____
_____	Hrs. Compressor at	_____			\$	_____
_____		_____			\$	_____
_____	Trucking	_____			\$	_____
_____	Pav't Patch	_____			\$	_____
_____		_____			\$	_____
_____		_____			\$	_____
_____		_____			\$	_____
_____		_____			\$	_____

St. WATER
 Pl. 88
 Ave. No. _____

Name of Owner _____

Labor and Mat'l. Report 19 _____

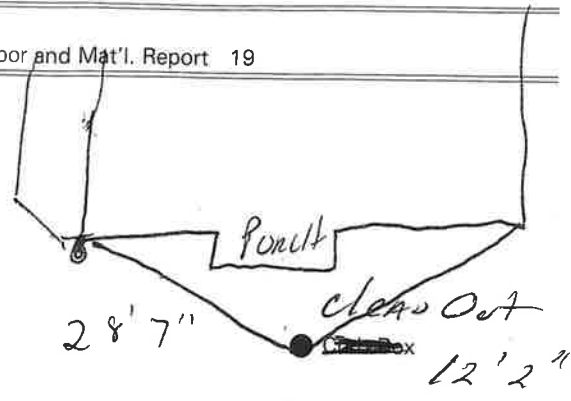

_____ Main Elev. of Main at tap _____

Gate at ● Gate at ●

● Curb Box