


Labor and Materials

.....	Copper	Connection.....	96
.....	Curb	Socket Valve } <i>ORISEN</i> Cap.....	133
.....	Service Box	Short 3 1/2 x 4 1/2	
.....	Old returned	Long 4 1/2 x 5 1/2	
		Buff, or Rdway	
34	3 1/4	Copper	
.....	Ft. 1/4	Galv. Iron	Pipe at 15
.....	in.	Cast Iron	495
.....	Nipples	in. at	
.....	Bushings	to in. at	
.....	Red'g	Couplings.....	to in. at
.....	Inc'g		
.....	Union	in. at	
.....	Meter	in. at	
.....	Lbs. Br. Stone	at	
.....	Lbs. Sand	at	
.....	Bags Cement	at	
.....	Paving Brick	Mack Red Asphalt } at	
.....	Lead Joints	at	
.....	Leadite Joints	at	
.....	Hrs. Foreman	at	
.....	Hrs. Common Labor	at	
.....	Hrs. Common Labor	at	
.....	Hrs. Mason	at	
.....	Hrs. Masons Helper	at	
.....	Hrs. Compressor	at	
.....	Compensation Iris		
.....	Trucking		
.....	Builders Use of Water		
Total \$.....			

Labor and Material Report

May 21 19 64

53 Warren St

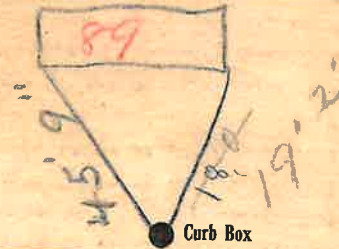

TAX ID# 310.5-3-9

10 Main

Elev. of Main at tap 5

Gate at ●

● Gate at

3/4" Copper

31' to main

● Curb Box

old sheet off at
head

curb box in street
at curb.

8-19-64

Sidewalk
Curb

□ SQUARE IRON

● Curb Box