


St. WARREN  
Pt. Ave. No. 96

Name of Owner  
TAX ID# 303.17-18-22

Labor and Mat'l. Report ~~49~~ 2006

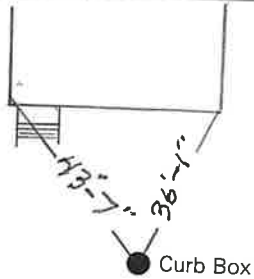


16 Main Elev. of Main at tap 5  
Gate at ● Gate at ●

● Curb Box

Labor and Material Report Aug 22 1927

62 Warren St.

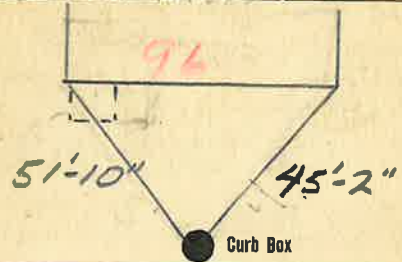

10 Main Elev. of Main at tap 4  
Gate at ● Gate at ●  
8' to MAIN

● Curb Box

Remeasured 1978

