


Labor and Materials

1	Copper	Connection	3/4"	\$	1.48
1	Lead				
1	Curb	Cock Valve T.S.&V.	3/4" in	\$	1.79
1	Service Box	Short 3 1/2 x 4 1/2			
	Old returned	Long 4 1/2 x 5 1/2		\$	1.46
		Buff. or Rawls			
23	Ft. 3/4"	Copper Galv. Iron Cast Iron	Pipe at	\$	5.94
	Nipples		in. at	\$	
	Bushings		to in. at	\$	
	Red'g Inc'g	Couplings	to in. at	\$	
	Union		in. at	\$	
	Meter		in. at	\$	
	Lbs. Br. Stone		at	\$	
	Lbs. Sand		at	\$	
	Bags Cement		at	\$	
	Paving Brick	Mack Red Asphalt	at	\$	
	Lead Joints		at	\$	
	Leadite Joints		at	\$	
26	Hrs. Foreman		at	\$	16.25
12	Hrs. Common Labor		at	\$	5.40
	Hrs. Common Labor		at	\$	
	Hrs. Mason		at	\$	
	Hrs. Masons Helper		at	\$	
3	Hrs. Compressor		at	\$	2.63
	Compensation Ins			\$	1.66
	Trucking			\$	1.00
	Builders Use of Water	Patch		\$	9.00
				Total	\$ 45.61

Labor and Material Report

1932

3/4" Tap at 113'

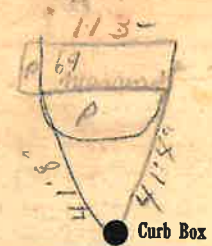

10 Main

Elev. of Main at tap 412.85

Gate at ● Gate at ●
 3/4" copper 33' to main
 ● Curb Box

Old tap shut off
 shut off at curb.
 Oct. 31-49.
 House razed

10122
 not on map

LABOR AND MATERIALS

Copper	} Connection	_____	\$	_____			
Lead							
Curb	} Cock Valve T. S. & V.	} _____ in.	\$	_____			
Service box	} { Short 3½ x 4½ Long 4½ x 5½ Buff or Rdway }	_____	\$	_____			
Old returned							
Ft.	} { Copper G. I. C. I. }	} Pipe at _____	\$	_____			
in.							
Nipples	in. at _____	\$	_____				
Bushings	to _____ in. at _____	\$	_____				
Red'g	} Coupl'gs	to _____ in. at _____	\$	_____			
Inc'g							
Union	in. at _____	\$	_____				
Meter	in. at _____	\$	_____				
Lead Joints	at _____	\$	_____				
Compound Joints	at _____	\$	_____				
Maintenance Foreman	_____	\$	_____				
Hrs. Water Maint. Man-1	at _____	\$	_____				
Hrs. Water Maint. Man-2	at _____	\$	_____				
Hrs. Garage Foreman	at _____	\$	_____				
Hrs. Labor	at _____	\$	_____				
Hrs. Compressor	at _____	\$	_____				
Compensation Ins. at \$	_____ per C	\$	_____				
Trucking	_____	\$	_____				
Pav't Patch	_____	\$	_____				
		\$	_____				
		\$	_____				
		\$	_____				
O'head	_____	\$	_____				
		\$	_____				

Warren

St.

~~Pl.~~


Ave. No. 113

Name of Owner

Ford Garage Co.

Measured-in

Labor and Mat'l Report Sept. 26 19 68

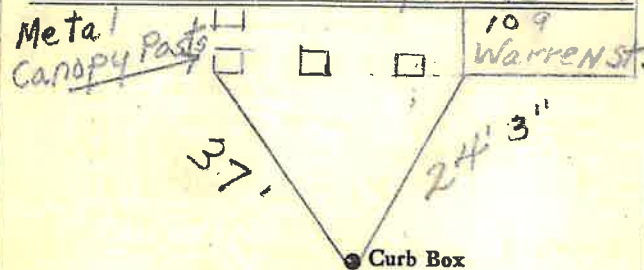

10" Main

Elev. of Main at tap 4 1/2'

Gate at ●

● Gate at

10/22

● Curb Box

not on map