

LABOR AND MATERIALS

Copper } Connection _____	\$ _____
Lead } _____	\$ _____
Curb } Cook Valve } _____ in.	\$ _____
} T. S. & V. } _____	\$ _____
Service box } Short 3½ x 4½ }	\$ _____
Old returned } Long 4½ x 5½ }	\$ _____
Ft. 1 in. } Copper } Pipe at _____	\$ _____
} G.I. }	\$ _____
} C.I. }	\$ _____
Nipples _____ in. at _____	\$ _____
Bushings _____ to _____ in. at _____	\$ _____
Red'g } Coupl'gs _____ to _____ in. at _____	\$ _____
Inc'g } _____	\$ _____
Union _____ in. at _____	\$ _____
Meter _____ in. at _____	\$ _____
_____	\$ _____
Compound Joints at _____	\$ _____
Maintenance Foreman _____	\$ _____
Hrs. Water Maint. Man—1 at _____	\$ _____
Hrs. Water Maint. Man—2 at _____	\$ _____
Hrs. Garage Foreman _____ at _____	\$ _____
Hrs. Labor— _____ at _____	\$ _____
Hrs. Compressor at _____	\$ _____
_____	\$ _____
Trucking _____	\$ _____
Pav't Patch _____	\$ _____
_____	\$ _____
_____	\$ _____
_____	\$ _____
_____	\$ _____

Warren \$


St. Pl. Ave. No. 5

Name of Owner

TAX ID # 310.5-2-5

Labor and Mat'l. Report

1986

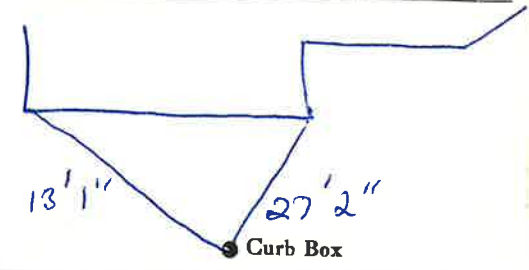

Main _____ Elev. of Main at tap _____
 Gate at • _____ • Gate at _____

• Curb Box

STOP in sidewalk by driveway on side