


For Bldg. in Rear.
25' to MAIN
Gate at ● 3/4" COPPER
Main at tap ●
Elev. of Main at tap 5-

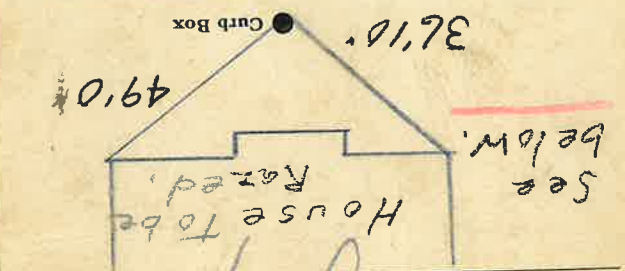

Labor and Mat'l. Report July 25 1949

Name of Owner TAX ID # 310.5-4-2
Rose # 115-# 117

Warren Ave. No. 115-
St. PL.


64

64

St. Warren
PL
Ave. No. 115-

Name of Owner TAX ID # 310.5-4-2
Rose # 115-# 117

Labor and Mat'l. Report July 25 1949

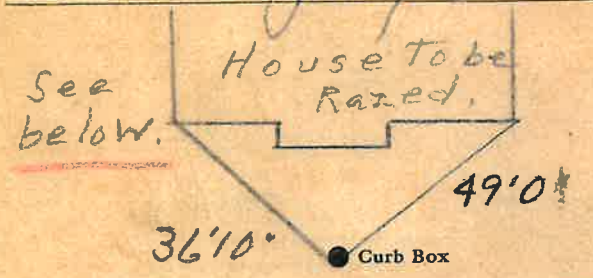

10 Main Elev. of Main at tap 5-

Gate at ● 3/4" COPPER Gate at ●
25' to MAIN
For Bldg. in Rear.

