

LABOR AND MATERIALS


Copper } Connection _____	\$ _____
Lead } _____	
Curb } Cock _____	\$ _____
} Valve _____	
} T. S. & V. _____	in. _____
Service box } Short 3½ x 4½ }	
Old returned } Long 4½ x 5½ }	\$ _____
Ft. <u>1½</u> in. } Copper } Pipe at _____	\$ _____
} G. I. }	
} C. I. }	
Nipples _____ in. at _____	\$ _____
Bushings _____ to _____ in. at _____	\$ _____
Red'g } _____	
Inc'g } Coupl'gs _____ to _____ in. at _____	\$ _____
Union _____ in. at _____	\$ _____
Meter _____ in. at _____	\$ _____
_____	\$ _____
Compound Joints at _____	\$ _____
Maintenance Foreman _____	\$ _____
Hrs. Water Maint. Man—1 at _____	\$ _____
Hrs. Water Maint. Man—2 at _____	\$ _____
Hrs. Garage Foreman _____ at _____	\$ _____
Hrs. Labor— _____ at _____	\$ _____
Hrs. Compressor at _____	\$ _____
_____	\$ _____
Trucking _____	\$ _____
Pav't Patch _____	\$ _____
_____	\$ _____
_____	\$ _____
_____	\$ _____
_____	\$ _____

WARREN

St. _____
Pl. _____
Ave. No. 123

Name of Owner _____

Labor and Mat'l. Report 1934

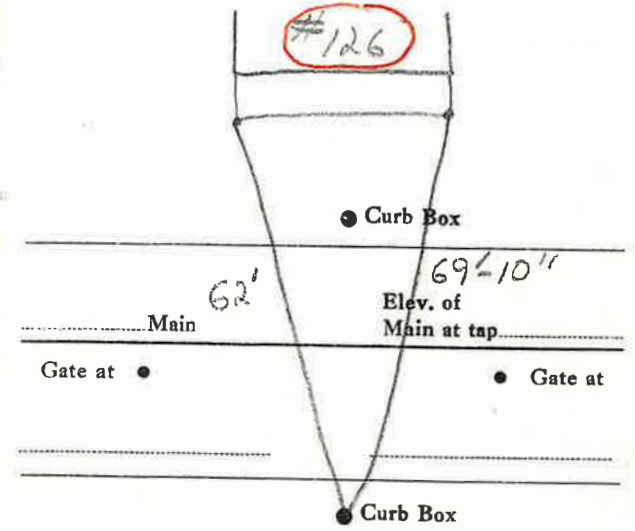

Not sure if this is #123 or #126