

LABOR AND MATERIALS


1	Copper	{ Connection	1 1/2"	\$ 7.40	
	Lead				
1	Curb	{ Cock Valve	in. 1 1/2"	\$ 5.78	
		T.S. & V.			
1	Service box	{ Short 3 1/2 x 4 1/2			
	Old returned	{ Long 4 1/2 x 5 1/2			
		Buff or Rdway		\$ 1.44	
32	Ft. 1 1/2 in.	{ Copper	Pipe at	\$ 6.28	
		C.I.			
		C.I.			
	Nipples	in. at		\$	
	Bushings	to in. at		\$	
	Red'g	{ Coupl'gs to in. at		\$	
	Inc'g				
	Union	in. at		\$	
	Meter	in. at		\$	
	Lead Joints at			\$	
	Compound Joints at			\$	
13	Hrs. Water Maint. Man-1 at	62 1/2		\$ 8.13	
4	Hrs. Water Maint. Man-2 at	50		\$ 2.00	
10	Hrs. Labor at	45		\$ 4.50	
	Hrs. Labor at			\$	
4	Hrs. Compressor at			\$ 6.00	
	Compensation Ins. at \$	per C.		\$ 0.53	
	Trucking			\$ 3.00	
	Pav't Patch			\$ 9.00	
				\$	
				\$	
				\$	
	O'head			\$	
				\$ 54.06	

123 or 125

St. 123
 --Pl--
 --Ave. No. 75

Name of Owner
 WARREN
 TAX ID # 310.5-4-1

Labor and Mat'l. Report May. 9 1934

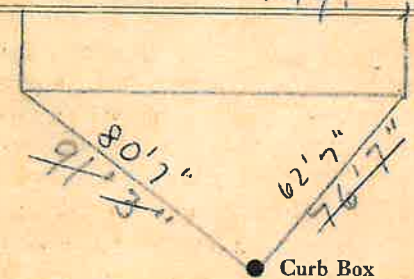

10' Main Elev. of Main at tap 5'

Gate at ● ● Gate at

1 1/2" Copper 32' to MAIN

● Curb Box

Measured IN from New Building 6-8-51