


### Labor and Materials

Copper } Connection.....		\$ 3 20
Lead } .....		
Curb { Cock Valve } .....	in.	\$ 1 00
{ F. S. & V. } .....		
Service Box } Short 3 1/2 x 4 } .....		\$ 1 30
Old returned } Long 4 1/2 x 5 } .....		
} Buff. or Rdway } .....		
30' 9" Ft. 3/4" in. { Copper } Pipe at.....		\$ 6 15
{ Galv. Iron } .....		
{ Cast Iron } .....		
Nipples.....	in. at.....	\$
Bushings.....	to..... in. at.....	\$
Red g } Couplings.....	to..... in. at.....	\$ 1 0
Inc g } .....		
Union.....	in. at.....	\$
Meter.....	in. at.....	\$
Lbs Br. Stone at.....		\$
Lbs. Sand at.....		\$
Bags Cement at.....		\$
Paving Brick { Mack } at.....		\$
{ Red } .....		
{ Asphalt } .....		
Lead Joints at.....		\$
Leadite Joints at.....		\$
2 Hrs. Foreman at.....	5 1/2	\$ 1 25
8 Hrs. Common Labor at.....	1 1/2	\$ 4 00
8 Hrs. Common Labor at.....	40' 1/2	\$ 3 25
Hrs. Mason at.....		\$
Hrs. Mason's Helper at.....		\$
Hrs. Compressor at.....		\$
Compensation Ins.....		\$ 2 3
Trucking.....		\$ 1 00
Builders' Use of Water.....		\$
Total \$ 21.49		

28-54

### Labor and Material Report

19

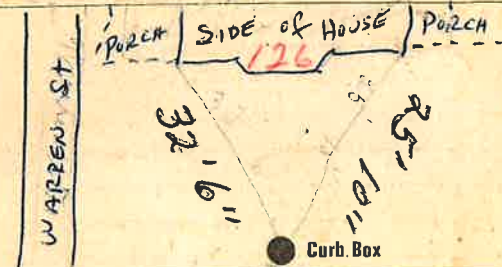

Main

Elev. of Main at tap 5'

Gate at

TAX ID# 303.17-19-24

Gate at

Curb Box

New curb stop to main - 5/87  
30' 9"