


27-200
Labor and Material Report *no 2* 1927

no 4 3/4 Warren st.

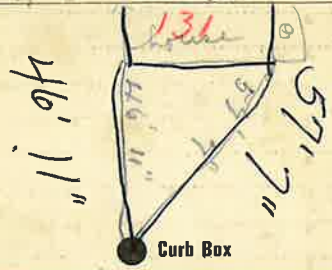

10" Main Elev. of Main at tap 5

Gate at 3/4" Copper Gate at 32' to MAIN


● Curb Box

Old Taps shut off
-1995- shut off is outside
Curb under gate cover -
stem inside

WARREN St. Pt. Ave. No. 131

Name of Owner
TAX ID# 803.17-24-7

Labor and Mat'l. Report 1927

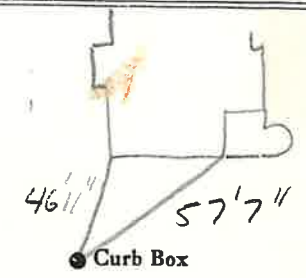

Main Elev. of Main at tap

Gate at ● Gate at ●

● Curb Box

