


LABOR AND MATERIALS

1	Copper Lead	Connection	1"	\$	4.28
1	Curb	Cock Valve T.S. & V.	1 in.	\$	5.25
1	Service box Old returned	Short 3 1/2 x 4 1/2 Long 4 1/2 x 5 1/2 Buff or Rdway		\$	4.69
7	Ft. 1 in.	Copper G.I. C.I.	Pipe at	56	\$ 7.28
	Nipples	in. at		\$	
	Bushings	to in. at		\$	
	Red'g Inc'g	Coupl'gs to in. at		\$	
	Union	in. at		\$	
	Meter	in. at		\$	
	Lead Joints	at		\$	
	Compound Joints	at		\$	
	Maintenance Foreman			\$	25.77
	Hrs. Water Maint. Man-1	at		\$	
6	Hrs. Water Maint. Man-2	at	1.24	\$	7.44
3	Hrs. Garage Foreman	at	1.59	\$	4.77
1.2	Hrs. Labor	at	1.13	\$	13.56
	Hrs. Compressor at			\$	
	Compensation Ins. at \$	4.29 per C		\$	1.11
	Trucking			\$	1.50
	Pav't Patch			\$	9.00
	Tap by Gissord & Lareau			\$	
	5-10-55			\$	
	O'head			\$	
				\$	58.99

St. 132-
Pl.
Ave. No. 134
Warren

Name of Owner CORNER OAK ST.
Sun Oil Co. (Filling Sta.)

Labor and Mat'l. Report May 10 19 55

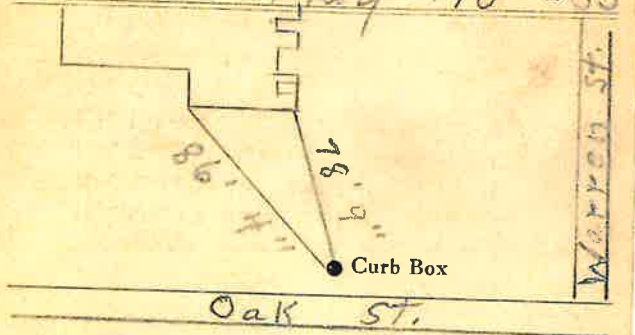

4" Main Elev. of Main at tap 6'

Gate at • • Gate at

7' to MAIN

• Curb Box

Tap on Oak St.

New curb stop to Main - 5/87