


14-53

St. Warren  
Pl. 135  
Ave. No. 135

Name of Owner B. H-0175017  
Gingras Waite Est.

Labor and Mat'l. Report Dec 9 1952

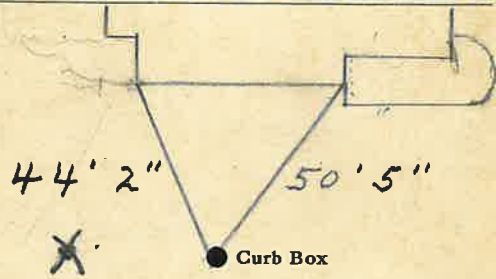

10" Main      Elev. of Main at tap 5 1/2'

Gate at ●      ● Gate at

3/4" Copper      32' to MAIN


● Curb Box

APV

Planned Parishhood St. Warren  
Pl. 135  
Ave. No. 135

Name of Owner  
TAY ID # 303.17-24-6

Labor and Mat'l. Report 3-10-15

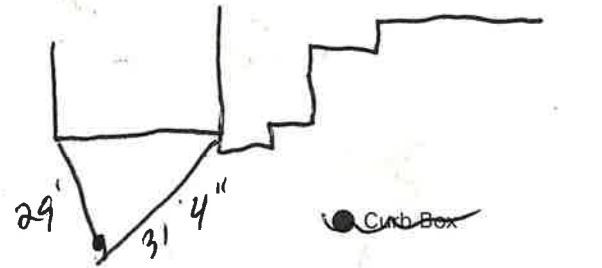

16" Main      Elev. of Main at tap

Gate at ●      ● Gate at

● Curb Box

Curb in parking by fence  
New water line 2003

