

LABOR AND MATERIALS

✓	Copper Lead	{ Connection	3/4	-----	\$ 1.23
✓	Curb	{ Cock Valve T. S. & V.	3/4 in.	-----	\$ 1.68
✓	Service Box Old returned	{ Short 3 1/2 x 4 1/2 Long 4 1/2 x 5 1/2 Buff. or Rdway		-----	\$ 1.54
33	Ft.	{ Copper Galv. Iron Cast Iron	3/4 in. Pipe at	-----	\$ 5.61
-----	Nipples	in. at		-----	\$
-----	Bushings	to in. at		-----	\$
-----	Red'g Inc'g	{ Couplings	to in. at	-----	\$
-----	Union	in. at		-----	\$
-----	Meter	in. at		-----	\$
-----	Lead Joints	at		-----	\$
-----	Leadite Joints	at		-----	\$
-----	Hrs. Foreman	at		-----	\$
6	Hrs. Chauffeur	at	12 1/2	-----	\$ 3.75
11 1/2	Hrs. Tapper	at	"	-----	\$ 7.19
16	Hrs. Labor	at	45	-----	\$ 7.20
-----	Hrs. Labor	at		-----	\$
4 1/2	Hrs. Compressor	at	65	-----	\$ 2.92
-----	Compensation Ins.			-----	\$.55
-----	Trucking			-----	\$ 1. --
-----	Builders Use of Water			-----	\$
-----	Tap by Hessel			-----	\$
-----	Patch - 1/2" secured Dept			-----	\$ 4.50
-----				-----	\$
-----				-----	\$ 37.17

7 - - 1939


St. 137
Pl. -
Ave. No. 81

Name of Owner

T. Donovan

Labor and Mat'l. Report

Mar 21 1939

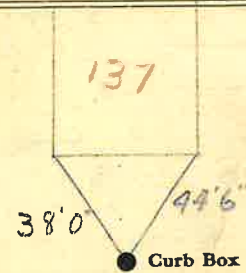

10 Main

Elev. of Main at tap 5 1/2

Gate at ●

● Gate at

3/4" copper

33' to main

● Curb Box

TAX ID # 303.17-24-5

New Tap