

LABOR AND MATERIALS

$\frac{3}{4}$ " Copper Lead Connection _____ \$ _____
 Curb } Cock Valve } _____ in. _____ \$ _____
 } T. S. & V. }
 Service box { Short $3\frac{1}{2}$ x $4\frac{1}{2}$ }
 Old returned { Long $4\frac{1}{2}$ x $5\frac{1}{2}$ } _____ \$ _____
 $30'$ Ft. $\frac{3}{4}$ " in. Copper } Pipe at _____ \$ _____
 } G. I. }
 } C. I. }
 Nipples _____ in. at _____ \$ _____
 Bushings _____ to _____ in. at _____ \$ _____
 Red'g } Coupl'gs _____ to _____ in. at _____ \$ _____
 Inc'g }
 Union _____ in. at _____ \$ _____
 Meter _____ in. at _____ \$ _____
 _____ \$ _____
 Compound Joints at _____ \$ _____
 Maintenance Foreman _____ \$ _____
 Hrs. Water Maint. Man—1 at _____ \$ _____
 Hrs. Water Maint. Man—2 at _____ \$ _____
 Hrs. Garage Foreman _____ at _____ \$ _____
 Hrs. Labor _____ at _____ \$ _____
 Hrs. Compressor at _____ \$ _____
 _____ \$ _____
 Trucking _____ \$ _____
 Pav't Patch _____ \$ _____
 _____ \$ _____
 _____ \$ _____
 _____ \$ _____
 _____ \$ _____

139 Warren

St.
Pl.


Ave. No. _____

Name of Owner

Fitzgerald

Labor and Mat'l. Report

19

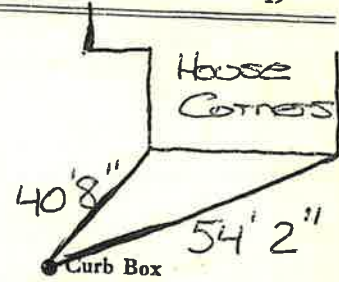

10" Main

Elev. of Main at tap $4\frac{1}{2}'$

Gate at ●

● Gate at

$\frac{3}{4}$ " Copper

30' to main

● Curb Box

Tap is off the left corner of house as you look at it.