
	V.
WARREN	St
Name of Owner Reed M	1. Allen
Labor and Mat'l. Report	Pug. 2/ 1973
10" Main	Elev. of Main at tap
Gate at	• Gate at
	• Curb Box
13 to MAIN	¥
7,0	
LSM-5C-6-1-67	

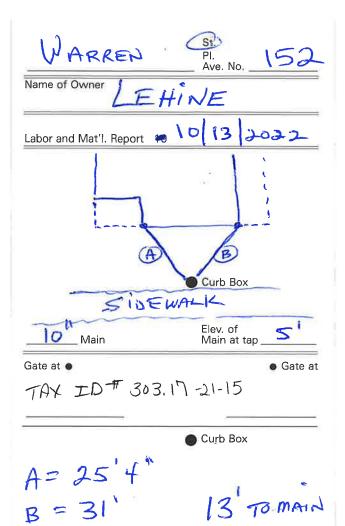

LABOR AND MATERIALS	
Copper Connection 3/2 Curb Cock Malve T. 8 8 V. Service box Old returned Short 3½ x 4½ Ruf or Rdway Color Rdway	scal)
12 3/4 (Copper)	- \$
Nipplesin. at	S
Bushings to in, at	
Red'ol	60
Inc'g Coupl'gs to in. at	
Union in, at	
Meterin, at	
Lead Joints at	- \$
Compound Joints at	\$
Maintenance Foreman	
Hrs. Water Maint. Man-1 at	\$
Hrs. Water Maint. Man-2 at	\$
Hrs. Garage Foreman at	\$
Hrs. Labor— at	\$
Hrs. Compressor at	
Compensation Ins. at \$per C	\$
Trucking	S
Pav't Patch	.S
TAP MAde 154 St To	18N 4CD
	S
HUO21-1973	S
O'hesd	\$
	•
	\$
	27

LABOR AND MATERIALS

Copper Connection	\$
Curb	
Service box Short 3-1/2 x 4-1/2 Old returned Long 4-1/2 x 5-1/2	_ \$
Ft in. {Copper G.l. C.l. } Pipe at	_ \$
Nipples in. at	
Bushings to in. at	\$
Red'g	
Inc'g	5
Union in. at	_ \$
Meter in. at	_ \$
	_ \$
Compound Joints at	_ \$
Maintenance Foreman	_ \$
Hrs. Water Maint. Man - 1 at	\$
Hrs. Water Maint. Man - 2 at	_ \$
Hrs. Garage Foreman at	_ \$
Hrs. Labor at	_ \$
Hrs. Compressor at	. \$
Trucking	_ s
Pav't Patch	_ \$
YY	s
2	s
9	\$
	\$