

LABOR AND MATERIALS

Copper	Connection	\$
Lead				
Curb	Cock Valve T. S. & V. } in.	\$
Service box Old returned	Short 3 1/2 x 4 1/2 Long 4 1/2 x 5 1/2 Buff or Rdway }	\$
Ft. / in.	Copper G.I. C.I. } Pipe at	\$
Nipples	in. at	\$
Bushings	to in. at	\$
Red'g Inc'g	Coupl'gs to in. at	\$
Union	in. at	\$
Meter	in. at	\$
Lead Joints	at	\$
Compound Joints	at	\$
Maintenance Foreman		\$
Hrs. Water Maint. Man-1	at	\$
Hrs. Water Maint. Man-2	at	\$
Hrs. Garage Foreman	at	\$
Hrs. Labor-	at	\$
Hrs. Compressor	at	\$
Compensation Ins. at \$	per C.	\$
Trucking		\$
Pav't Patch		\$
Wheel valve		\$
		\$
		\$
O'head		\$
		\$


Warren ST St. Pl. Ave. No. 153

Name of Owner

Dr. Ryan

TAX ID # 303.17-24-2
Labor and Mat'l. Report

19

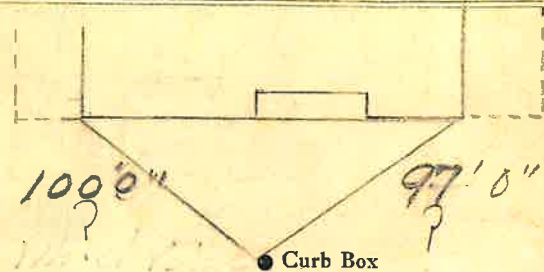

10 Main

Elev. of Main at tap 5'

Gate at •

• Gate at

CHANGED WHEEL VALVE TO
REGULAR 1 1/2" BOX + STEM - 1995 -
BOX BETWEEN SWK. + CURB

• Curb Box

Measured in Card
Feb 8 - 1955 by
Gifford