

LABOR AND MATERIALS

Copper	Lead	Connection	3/4		\$ 2.87
Curb	Valve	T. S. & V.	3/4	in.	\$ 3.62
Service box	Old returned	Short	3 1/2	X	4 1/2
		Long	4 1/2	X	5 1/2
		Buff or Rdway			\$ 4.68
11	Ft.	in.		Pipe at	3/4 \$ 3.52
				Copper	
				G. I.	
				C. I.	
	Nipples	in.	at		\$
	Bushings	to	in.	at	\$
	Red'g				\$
	Inc'g	Coupl'gs	to	in.	at
					\$
	Union	in.	at		\$
	Meter	in.	at		\$
	Lead Joints	at			\$
	Compound Joints	at			\$
	Hrs. Water Maint. Man	—1	at		\$
13 1/2	Hrs. Water Maint. Man	—2	at	1.02	\$ 13.77
21 1/2	Hrs. Labor	—	at	91	\$ 19.57
	Hrs. Labor	—	at		\$
2	Hrs. Compressor	at		1.20	\$ 2.40
	Compensation Ins.	at \$			\$ 73
	Trucking				\$ 2.00
	Pav't Patch				\$ 14.85
	Tap by 1 1/2" main				\$
	O'head				\$
					\$ 68.01

89

St.

Warren

~~Pl.~~


Ave. No. *10*

Name of Owner

Epstein

Labor and Mat'l. Report

Aug 31 1949

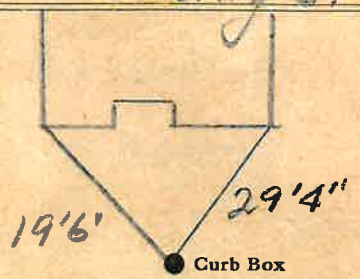

10 Main

Elev. of

Main at tap *5*

Gate at ●

● Gate at

3/4" Copper

11' to main

● Curb Box

TAX ID # *303.17-16-10*