


WARREN ST St.
Pl. Ave. No. 161

Name of Owner

Hyde TAX ID# 303.17-24-1

Labor and Mat'l. Report

19

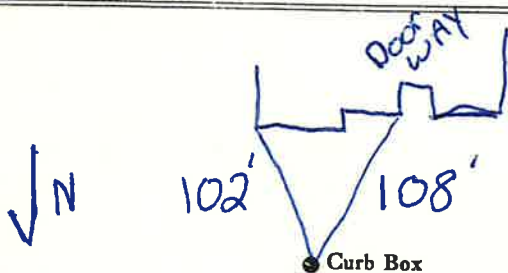

Main

Elev. of Main at tap

Gate at

Gate at

1/4" Copper 33' to main

new measurements
5-20-96


WARREN St.
Pl. Ave. No. 161

Name of Owner

Hyde

Labor and Mat'l. Report

April 22 19 59

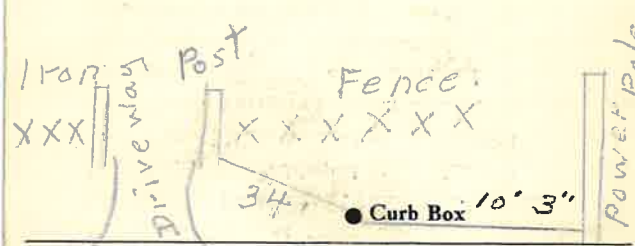

10" Main

Elev. of Main at tap

Gate at

Gate at

Renewal Tap 1/4"

LABOR AND MATERIALS

Copper	}	Connection	\$
Lead					
Curb	}	Cock	in.	\$
		Valve			
		T. S. & V.			
Service box	}	Short $3\frac{1}{2} \times 4\frac{1}{2}$		\$
Old returned		Long $4\frac{1}{2} \times 5\frac{1}{2}$			
		Buff or Rdway			
Ft. in.	}	Copper	} Pipe at	\$
		G. I.			
		C. I.			
Nipples	in. at			\$
Bushings	to	in. at		\$
Red'g	}	Coupl'gs	to	in. at	\$
Inc'g					
Union	in. at			\$
Meter	in. at			\$
Lead Joints at				\$
Compound Joints at				\$
Maintenance Foreman				\$
Hrs. Water Maint. Man—1 at				\$
Hrs. Water Maint. Man—2 at				\$
Hrs. Garage Foreman	at			\$
Hrs. Labor—	at			\$
Hrs. Compressor at				\$
Compensation Ins. at \$	per C			\$
Trucking				\$
Pav't Patch				\$
				\$
				\$
				\$
O'head				\$
				\$

LABOR AND MATERIALS

1	Copper	}	Connection	\$
	Lead					
1	Curb	}	Cock	in.	\$
			Valve			
			T. S. & V.			
1	Service box	}	Short $3\frac{1}{2} \times 4\frac{1}{2}$		\$
	Old returned		Long $4\frac{1}{2} \times 5\frac{1}{2}$			
			Buff or Rdway			
33	Ft. $1\frac{1}{4}$ in.	}	Copper	} Pipe at	\$
			G. I.			
			C. I.			
	Nipples	in. at			\$
	Bushings	to	in. at		\$
	Red'g	}	Coupl'gs	to	in. at	\$
	Inc'g					
	Union	in. at			\$
	Meter	in. at			\$
	Lead Joints at				\$
	Compound Joints at				\$
	Maintenance Foreman				\$
	Hrs. Water Maint. Man—1 at				\$
	Hrs. Water Maint. Man—2 at				\$
	Hrs. Garage Foreman	at			\$
	Hrs. Labor—	at			\$
	Hrs. Compressor at				\$
	Compensation Ins. at \$	per C			\$
	Trucking				\$
	Pav't Patch				\$
	<i>Tap by Giesbard & Co.</i>					
	<i>4 - 22 - 59.</i>					
					\$
	O'head				\$
					\$

LABOR AND MATERIALS


Copper	Connection	_____	\$	_____			
Lead							
Curb	Cock Valve T. S. & V.	} _____ in.	\$	_____			
					Service box	} Short 3½ x 4½	\$
Ft. _____ in.	} Copper G. I. C. I.	} Pipe at _____	\$	_____			
Nipples _____ in.					at _____	\$	_____
Bushings _____	to _____ in.	at _____	\$	_____			
Red'g } Inc'g }	Coupl'gs _____	to _____ in.	at _____	\$			
Union _____					in. at _____	\$	_____
Meter _____	in. at _____	\$	_____				
Lead Joints at _____		\$	_____				
Compound Joints at _____		\$	_____				
Maintenance Foreman _____		\$	_____				
Hrs. Water Maint. Man—1 at _____		\$	_____				
Hrs. Water Maint. Man—2 at _____		\$	_____				
Hrs. Garage Foreman _____ at _____		\$	_____				
Hrs. Labor— _____ at _____		\$	_____				
Hrs. Compressor at _____		\$	_____				
Compensation Ins. at \$ _____ per C.		\$	_____				
Trucking _____		\$	_____				
Pav't Patch _____		\$	_____				
_____		\$	_____				
_____		\$	_____				
_____		\$	_____				
O'head _____		\$	_____				

St. _____
-Pl- _____
Ave. No. 161

Name of Owner _____

Hyde

Labor and Mat'l. Report _____ 19 _____

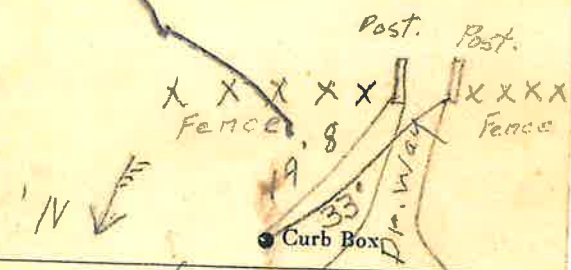

Warren St.

10" Main _____ Elev. of Main at tap 4-5'

Gate at • _____ • Gate at _____

This • Curb Box
Old Tap
to be dug up.
1 1/4" Renewal
TOP 4-22-59