

LABOR AND MATERIALS

Copper	} Connection		\$
Lead			
Curb	} Cock Valve T. S. & V.	in.	\$
Service box		{ Short 3½ x 4½ Long 4½ x 5½ Buff or Rdway }	
Old returned			
	\$		
<u>10</u> Ft.	} Copper G.I. C.I.	Pipe at	\$
in.			
Nipples	in. at	\$	
Bushings	to in. at	\$	
Red'g	} Coupl'gs	to in. at	\$
Inc'g			
Union	in. at	\$	
Meter	in. at	\$	
Lead Joints	at	\$	
Compound Joints	at	\$	
Maintenance Foreman		\$	
Hrs. Water Maint. Man-1	at	\$	
Hrs. Water Maint. Man-2	at	\$	
Hrs. Garage Foreman	at	\$	
Hrs. Labor	at	\$	
Hrs. Compressor	at	\$	
Compensation Ins. at \$	per C	\$	
Trucking		\$	
Pav't Patch		\$	
		\$	
		\$	
		\$	
O'head		\$	
		\$	

St.
Pl.
Ave. No. 162

WARREN


Name of Owner

TAX ID # 303.17-22-10

Labor and Mat'l. Report

6-9

19 86

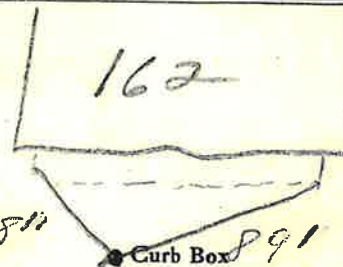

10' to Main

Elev. of
Main at tap

Gate at ●

● Gate at

● Curb Box

2" Tap