

Warren


St.
 Pl.
 Ave. No. 169

Name of Owner

CUNNINGHAM

Labor and Mat'l. Report

July 23 1956

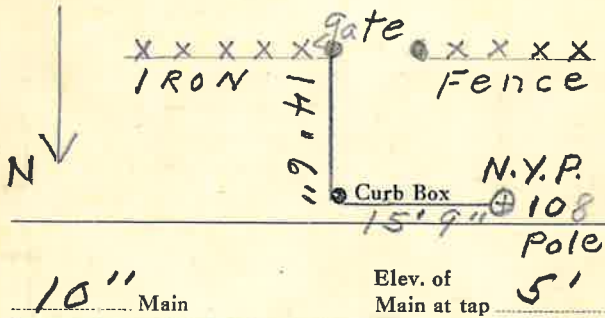

Gate at •

• Gate at

• Curb Box

WARREN


St.
 Pl.
 Ave. No. 169

Name of Owner

HYDE MUSEUM

Labor and Mat'l. Report

1988

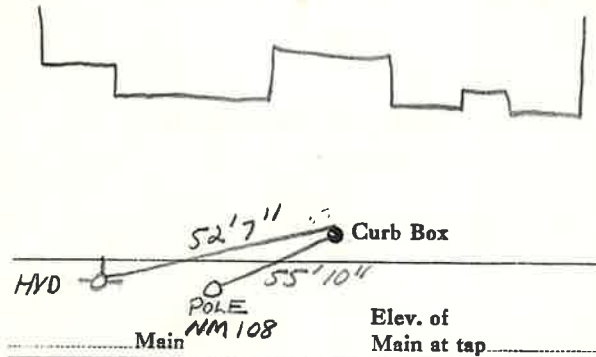

Gate at •

• Gate at

2" Copper

29' to main

• Curb Box

Hyde as #161

GATE IN DRIVEWAY

LABOR AND MATERIALS

1	Copper Lead	Connection	1"	\$	4.28
1	Curb	Cock Valve T.S. & V.	1 in.	\$	5.25
1	Service box Old returned	Short 3 1/2 x 4 1/2 Long 4 1/2 x 5 1/2 Buff or Rdway	5x6'	\$	
29	Ft. 1 in.	Copper G.I. Pipe	at 1.24	\$	35.06
	Nipples	in. at		\$	
	Bushings	to in. at		\$	
	Red'g Inc'g	Coupl'gs to in. at		\$	
	Union	in. at		\$	
	Meter	in. at		\$	
	Lead Joints at			\$	
	Compound Joints at			\$	
4	Maintenance Foreman		1.937	\$	7.75
	Hrs. Water Maint. Man-1	at		\$	
16	Hrs. Water Maint. Man-2	at	1.613	\$	25.81
1	Hrs. Garage Foreman	at		\$	2.03
1	Hrs. Labor	at	1.30	\$	11.70
35	Hrs. Compressor at	5 hrs. 1.00		\$	35.00
	Compensation Ins. at	\$ 5.86 per C		\$	4.69
	Trucking			\$	1.50
	Pav't Patch			\$	9.00
	Tap by Gifford & Co.			\$	
			7-23-56	\$	
	O'head			\$	

LABOR AND MATERIALS

Copper Lead	Connection		\$
Curb	Cock Valve T.S. & V.	in.	\$
Service box Old returned	Short 3 1/2 x 4 1/2 Long 4 1/2 x 5 1/2		\$
Ft. 2 in.	Copper G.I. Pipe	at	\$
Nipples	in. at		\$
Bushings	to in. at		\$
Red'g Inc'g	Coupl'gs to in. at		\$
Union	in. at		\$
Meter	in. at		\$
Compound Joints at			\$
Maintenance Foreman			\$
Hrs. Water Maint. Man-1	at		\$
Hrs. Water Maint. Man-2	at		\$
Hrs. Garage Foreman	at		\$
Hrs. Labor	at		\$
Hrs. Compressor at			\$
Trucking			\$
Pav't Patch			\$