

LABOR AND MATERIALS

Copper	} Connection		\$
Lead			
1	} Cock Valve T. S. & V. }	10 1/2 in.	\$
1		} Short 3 1/2 x 4 1/2 Long 4 1/2 x 5 1/2 }	
Service box Old returned			
7	} Copper C. I. C. I. }	6" in.	Pipe at \$
Nipples		in. at \$	
Bushings		to in. at \$	
Red'g Inc'g	} Coupl'gs	to in. at \$	
Union		in. at \$	
Meter	in. at \$		
Compound Joints	at \$		
Maintenance Foreman	\$		
Hrs. Water Maint. Man-1	at \$		
Hrs. Water Maint. Man-2	at \$		
Hrs. Garage Foreman	at \$		
Hrs. Labor	at \$		
Hrs. Compressor	at \$		
Trucking	\$		
Pav't Patch	\$		
	\$		
	\$		
	\$		
	\$		

178-184

WARREN


St. Pt. Ave. No. 178

Name of Owner

HOME FOR AGED WOMEN

Labor and Mat'l. Report

NOV 1945

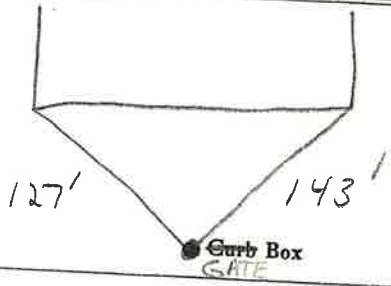

10 Main

Elev. of Main at tap 5 1/2

Gate at ●

● Gate at

6" CI

7' to MAIN

● Curb Box

6" TAP