


55-36
Labor and Material Report

7.14 1936

106 Warren St

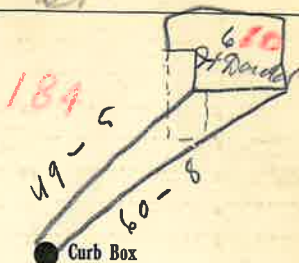

4 Main

Elev. of Main at tap 5.2

Gate at ●

● Gate at

● Curb Box

Tap made on
McDonald St #6
134-#6 10
For green House

1" Tap Near Tap

41' to main

55-36
Labor and Material Report

Nov 23 1936

106 Warren St 1" Tap
old hades house



10' Main

Elev of Main at tap 4

Gate at ●

● Gate at

● Curb Box

Old tap shut off

1" Tap.
For Home

shut off at curb
box due to leak.
New 1" Tap inside
cellar on sprinkler line

Labor and Materials

1	Copper	} Connection	\$
1	Lead		\$
1	Curb	{ Cock Valve T.S.&V. }	1" in	\$
1	Service Box		{ Short 3 1/2 x 4 1/2 Long 4 1/2 x 5 1/2 Buff. or Rdway }
	Old returned		
9	Ft. 1"	{ Copper Galv. Iron Cast Iron }	Pipe at	\$
1	Nipples 1"		in. at	6" <i>h.w.g.</i>
	Bushingstoin. at	\$
1	Red'g Inc'g	{ Couplings. 1" to 1 1/4 }	in. at	\$
	Union	in. at
	Meterin. at	\$
	Lbs. Br. Stone	at	\$
	Lbs. Sand	at	\$
	Bags Cement	at	\$
	Paving Brick	{ Mack Red Asphalt }	at	\$
	Lead Joints		at
	Leadite Joints	at	\$
	Hrs. Foreman	at	\$
	Hrs. Common Labor	at	\$
	Hrs. Common Labor	at	\$
	Hrs. Mason	at	\$
	Hrs. Masons Helper	at	\$
	Hrs. Compressor	at	\$
	Compensation Ins	\$
	Trucking	\$
	Builders Use of Water	\$
Total \$			

Labor and Materials

	Copper	} Connection	\$
	Lead		
	Curb	{ Cock Valve T.S.&V. }in	\$
	Service Box		{ Short 3 1/2 x 4 1/2 Long 4 1/2 x 5 1/2 Buff. or Rdway }
	Old returned		
4	Ft. 1"	{ Copper Galv. Iron Cast Iron }	Pipe at	\$
	Nipples	in. at
	Bushingstoin. at	\$
	Red'g Inc'g	{ Couplings.....toin. at	\$
	Union	in. at
	Meterin. at	\$
	Lbs. Br. Stone	at	\$
	Lbs. Sand	at	\$
	Bags Cement	at	\$
	Paving Brick	{ Mack Red Asphalt }	at	\$
	Lead Joints		at
	Leadite Joints	at	\$
	Hrs. Foreman	at	\$
	Hrs. Common Labor	at	\$
	Hrs. Common Labor	at	\$
	Hrs. Mason	at	\$
	Hrs. Masons Helper	at	\$
	Hrs. Compressor	at	\$
	Compensation Ins	\$
	Trucking	\$
	Builders Use of Water	<i>Patch</i>	\$ <i>5.-</i>
Total \$			



49'-5"

60'8"

41'- 1" Copper

1" Copper tap for
184 WARREN ST
Rear old Ladies
Home. Tap is on
MEDONALD ST.
Measured from
10 MEDONALD ST

over