


LABOR AND MATERIALS

1	Copper	} Connection	3/4"	\$
	Lead			
1	Curb	} 3/4 in. Oriseat,		\$
	Cock			
	Valve			
	T.S. & V.			
1	Service box	} Short 3 1/2 x 4 1/2		\$
	Old returned		Long 4 1/2 x 5 1/2	
			Buff or Rdway	
14	Ft. 3/4 in.	} Copper		\$
			G.I.	
			C.I.	
			Pipe at	\$
	Nipples	in. at		\$
	Bushings	to in. at		\$
	Red'g	} Coupl'gs. to in. at		\$
	Inc'g			
	Union	in. at		\$
	Meter	in. at		\$
	Lead Joints at			\$
	Compound Joints at			\$
	Maintenance Foreman			\$
	Hrs. Water Maint. Man-1 at			\$
	Hrs. Water Maint. Man-2 at			\$
	Hrs. Garage Foreman at			\$
	Hrs. Labor at			\$
	Hrs. Compressor at			\$
	Compensation Ins. at \$	per C.		\$
	Trucking			\$
	Pav't Patch			\$
	Tap by Gifford & Co.			\$
				\$
				\$
				\$
	O'head			\$
				\$

Warren St. Ave. No. 188

Name of Owner
Accardi

Labor and Mat'l. Report Apr. 1 1966

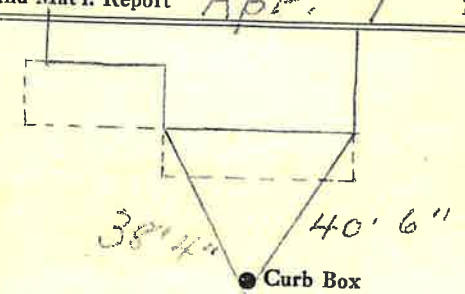

10" Main Elev. of Main at tap 5 1/2'

Gate at ● Gate at ●
3/4" Copper 14' to main

● Curb Box
TAX ID # 303.17-23-5