

LABOR AND MATERIALS


1	Copper	} Connection $\frac{3}{4}$ "	\$
1	Lead		
1	Curb	} $\frac{3}{4}$ " Oriseal	\$
	Cock		
	Valve		
	T.S. & V.		
1	Service box	} Short $3\frac{1}{2}$ x $4\frac{1}{2}$	\$
	Old returned		
		Long $4\frac{1}{2}$ x $5\frac{1}{2}$	
		Buff or Rdway	
14	Ft. $\frac{3}{4}$ in.	} Pipe at	\$
	Nipples	in. at	\$
	Bushings	to in. at	\$
	Red'g		
	Inc'g	Coupl'gs to in. at	\$
	Union	in. at	\$
	Meter	in. at	\$
	Lead Joints	at	\$
	Compound Joints	at	\$
	Maintenance Foreman		\$
	Hrs. Water Maint. Man-1	at	\$
	Hrs. Water Maint. Man-2	at	\$
	Hrs. Garage Foreman	at	\$
	Hrs. Labor	at	\$
	Hrs. Compressor	at	\$
	Compensation Ins. at \$	per C	\$
	Trucking		\$
	Pav't Patch		\$
	Tap by Laroau & Co.		\$
			\$
			\$
	O'head		\$
			\$

5-15-64

Warren St. Ave. No. 12

Name of Owner  
Margaret Corsones

Labor and Mat'l. Report May 15 1964

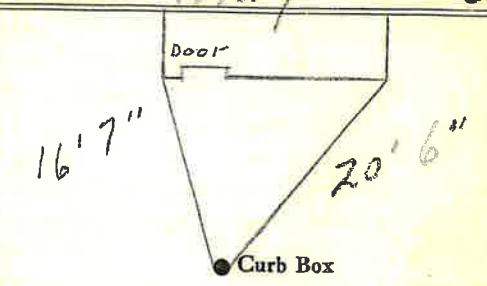

10" Main Elev. of Main at tap 4'

Gate at • Gate at •  
 $\frac{3}{4}$ " Copper 14' to main

• Curb Box

TAX ID# 303.17-16-11