

WARREN

St.
Pl.
Ave. No.


189

Name of Owner

KIM STODDARD

Labor and Mat'l. Report to

11/6/1930 ORG.

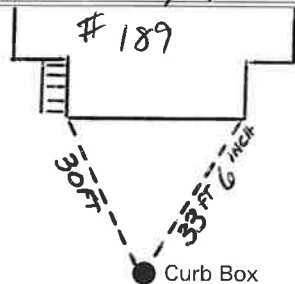

10" Main

Elev. of Main at tap 6'

Gate at ●

● Gate at

3/4" COPPER 35' to MAIN

LEFT SIDE 30' ● Curb Box
RIGHT SIDE 33'6"


TAX ID # 303.18-19-12

30-160

Labor and Material Report

Nov. 6 1930

115 ¹⁸⁹ Warren St

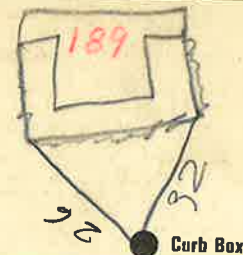


10 Main

Elev of Main at tap 6

Gate at ●

● Gate at

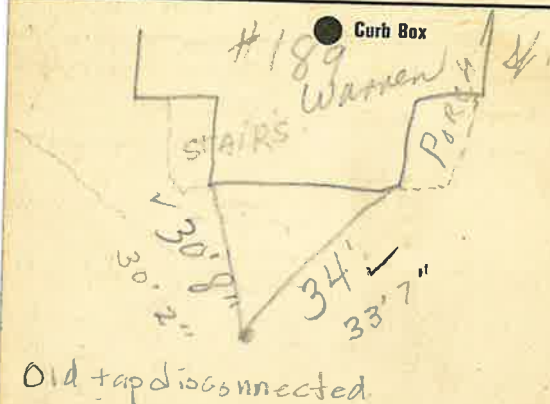

LABOR AND MATERIALS

_____	Copper } Connection _____	\$ _____
_____	Lead } _____	\$ _____
_____	Curb } Cock } _____ in.	\$ _____
_____	} Valve } _____	\$ _____
_____	} T.S. & V. } _____	\$ _____
_____	Service box { Short 3-1/2 x 4-1/2 } _____	\$ _____
_____	Old returned { Long 4-1/2 x 5-1/2 } _____	\$ _____
<u>35'</u>	Ft. <u>3/4"</u> in. { Copper } Pipe at _____	\$ _____
_____	} Cast Iron } _____	\$ _____
_____	Nipples _____ in. at _____	\$ _____
_____	Bushings _____ to _____ in. at _____	\$ _____
_____	Red'g _____	\$ _____
_____	Inc'g _____	\$ _____
_____	Union _____ in. at _____	\$ _____
_____	Meter _____ in. at _____	\$ _____
_____	_____	\$ _____
_____	Compound Joints at _____	\$ _____
<u>6</u>	Maintenance Foreman _____	\$ _____
<u>11</u>	Hrs. Water Maint. Man - 1 at _____	\$ _____
<u>11</u>	Hrs. Water Maint. Man - 2 at _____	\$ _____
_____	Hrs. Garage Foreman _____ at _____	\$ _____
_____	Hrs. Labor _____ at _____	\$ _____
<u>2</u>	Hrs. Compressor at _____	\$ _____
_____	_____	\$ _____
_____	Trucking _____	\$ _____
_____	Pav't Patch _____	\$ _____
_____	_____	\$ _____
_____	_____	\$ _____
_____	_____	\$ _____
_____	_____	\$ _____

Labor and Materials

_____	Copper } Connection _____	$\frac{3}{4}$	\$ 2.70
1	Lead } _____	$\frac{3}{4}$	\$ 2.39
1	Curb } Cock } _____ in.	$\frac{3}{4}$	\$ 1.55
_____	} Valve } _____		\$ 9.45
_____	} T.S. & V. } _____		\$ _____
1	Service Box { Short 3-1/2 x 4-1/2 } _____		\$ _____
_____	Old returned { Long 4-1/2 x 5-1/2 } _____		\$ _____
_____	} Buff. or Rdway } _____		\$ _____
<u>35'</u>	Ft. _____ in. { Copper } Pipe at _____	$\frac{3}{4}$	\$ _____
_____	} Cast Iron } _____		\$ _____
_____	Nipples _____ in. at _____		\$ _____
_____	Bushings _____ to _____ in. at _____		\$ _____
_____	Red'g } Couplings _____ to _____ in. at _____		\$ _____
_____	Inc'g } _____		\$ _____
_____	Union _____ in. at _____		\$ _____
_____	Meter _____ in. at _____		\$ _____
_____	Lbs. Br. Stone at _____		\$ _____
_____	Lbs. Sand at _____		\$ _____
_____	Bags Cement at _____		\$ _____
_____	Paving Brick { Mack } at _____		\$ _____
_____	} Red } _____		\$ _____
_____	} Asphalt } _____		\$ _____
_____	Lead Joints at _____		\$ _____
_____	Leadite Joints at _____		\$ _____
<u>6</u>	Hrs. Foreman at _____		\$ 3.75
<u>11</u>	Hrs. Common Labor at _____	Tapper @ .50	\$ 5.50
<u>11</u>	Hrs. Common Labor at _____	.45	\$ 4.95
_____	Hrs. Mason at _____		\$ _____
_____	Hrs. Mason's Helper at _____		\$ _____
<u>2</u>	Hrs. Compressor at _____	1.50	\$ 3.00
_____	Compensation Ins _____		\$.44
_____	Trucking _____		\$ 1.00
_____	Builders' Use of Water _____	Patch	\$ 23.00

Total \$ 57.73