

41-47

BARN
IN
BACK A
Pl.
Ave. No. 192


Wagon

Name of Owner

Rose

Labor and Mat'l. Report

June 27 1947

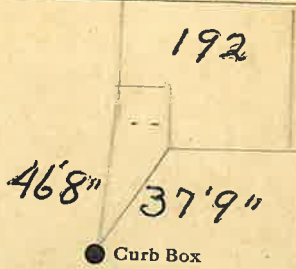

10" Main

Elev. of Main at tap 7'

Gate at ●

● Gate at

3/4" Copper


14' to main

● Curb Box

LSM-5C-6-1-45

Labor and Material Report Aug 13 1947

#114 Wagon St.

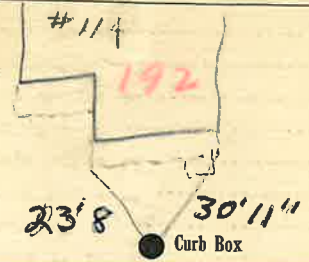

Main

Elev. of Main at tap

Gate at ●

● Gate at

● Curb Box

Measurement to
114 Wagon St

Box in side walk.

10/22
not on map

Part of #196 - Stewarts

