


WARREN

St. Pl. Ave. No. 194

Name of Owner

Labor and Mat'l. Report

A = 24'8"
B = 32'6"

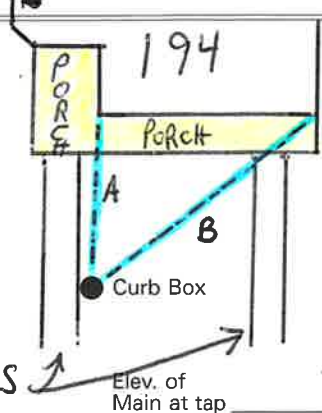

Gate at

Gate at

Curb Box

65.8" to MAIN FROM CURB BOX

10/22
Not on map
Part of #196 - Stewarts

89-1937

Warren St

St. Pl. Ave. No. 194 1.16


Name of Owner

Sweeney

Labor and Mat'l. Report

July 21 1937

OLD WATER MAIN

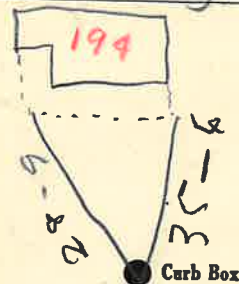

10 Main

Elev. of Main at tap 5

Gate at

3/4" Copper

Gate at 12' to MAIN

Curb Box

did shut off

St.

