

17-1938 Copied 11-21-63


Warren

St. 196-198
Pl. 118-120
Ave. No.

Name of Owner

Wick + Rice

Labor and Mat'l. Report May 5 1938

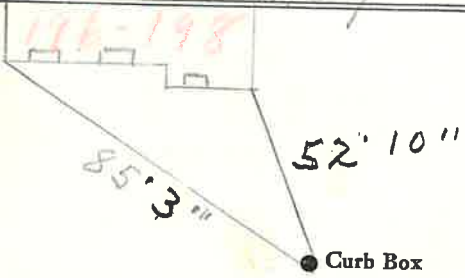

10" Main

Elev. of Main at tap 5'

Gate at ●

● Gate at

3/4" Copper

14' 6" main

● Curb Box

LSM-8C-3-10-61


12/2/11

Stewarts Shop

St. 196
Pl. Warren St
Ave. No.

Name of Owner

Labor and Mat'l. Report 19

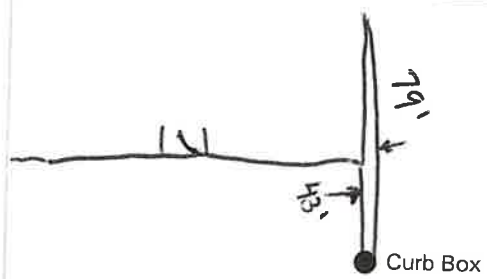

Main

Elev. of Main at tap

Gate at ●

● Gate at

TAX ID # 303.18-11-10

● Curb Box

Right Back side of Building
79'

Right Front of Building
43'

