


Labor and Material Report

July 23 1936

199 Warren St

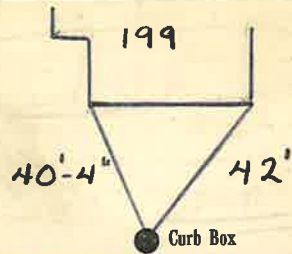

10 Main

Elev. of Main at tap 42

Gate at ●

● Gate at

● Curb Box

New Tap 37' from main


*[Handwritten signature]*

Warren St

St. Pl. Ave. No. 199

Name of Owner

Labor and Mat'l. Report 2009

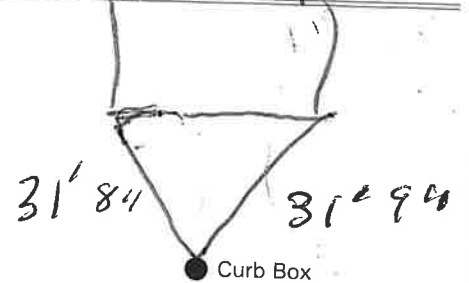

16" Main

Elev. of Main at tap

Gate at ●

● Gate at

TAX ID# 303.18-19-7

● Curb Box

