


Warren St  
St. No. 204  
Ave. No. 204

Name of Owner  
M.J. Abramams

Labor and Mat'l. Report Aug. 27 1958

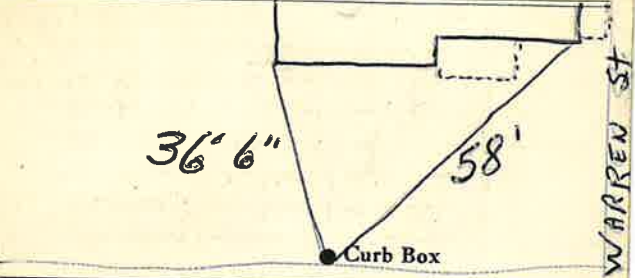

McDONALD ST.  
8" Main Elev. of Main at tap 6'


Gate at • Gate at  
3/4" COPPER 15' to MAIN

• Curb Box  
This Tap on  
McDonald St.  
TAX ID # 303.18-12-110

Warren ST  
St. No. 204  
PL. No. 127

Name of Owner

Labor and Mat'l. Report Sept 11 1958

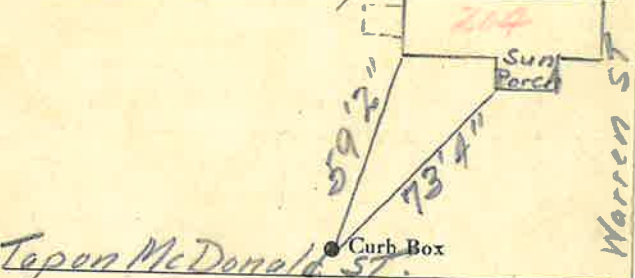

Tap on McDonald ST.  
8" 1958  
4" Main Elev. of Main at tap 5-6'

Gate at • Gate at  
11' to 1/2' to MAIN

• Curb Box  
This is a Lot Tap

