

Labor and Materials


1	Copper Lead	Connection	3/4"	\$ 3.20
1	Curb	Cock Valve T.S. & V.	3/4"	\$ 1.00
1	Service Box	Short 3/4x1 1/2		\$ 1.40
	Old returned	Long 4 1/2x5 1/2	Buff. or Rdway	
6	Ft. 3/4 in.	Copper Galv. Iron Cast-iron	Pipe at	\$ 1.32
	Nipples	in. at		\$
	Bushings	to in. at		\$
	Red'g Inc'g	Couplings	to in. at	\$
	Union	in. at		\$
	Meter	in. at		\$
	Lbs. Br. Stone	at		\$
	Lbs. Sand	at		\$
	Bags Cement	at		\$
	Paving Brick	Mack Red Asphalt	at	\$
	Lead Joints	at		\$
	Leadite Joints	at		\$
12	Hrs. Foreman	at	62 1/2	\$ 6.25
9	Hrs. Common Labor	at	40 1/2	\$ 3.62
	Hrs. Common Labor	at		\$
	Hrs. Mason	at		\$
	Hrs. Mason's Helper	at		\$
1	Hrs. Compressor	at		\$ 11.50
	Compensation Ins			\$ 20
	Trucking			\$ 100
	Builders' Use of Water			\$

Total \$ 195.3

Labor and Material Report

1928

28-32
Tap at 124. ... at

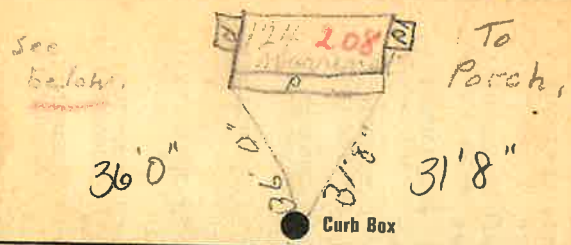

10' Main Elev of Main at tap 5'4"

Gate at TAX ID # 303.18-12-17 Gate at

