

WARREN


St. Pl. Ave. No. 209-A

Name of Owner

JOINTA LIME CO.

Labor and Mat'l. Report

AUG. 10 19 73

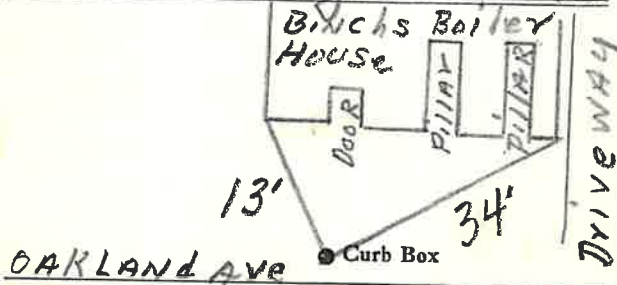

OAKLAND AVE

8" C.I. Main

Elev. of Main at tap 4'

Gate at ●

● Gate at

● Curb Box

REAR OF 209 WARREN ST.
10122
Not on map

REAR OF PROPERTY

WARREN


St. Pl. Ave. No. 209-A

Name of Owner

JOINTA LIME CO.

Labor and Mat'l. Report

19 73

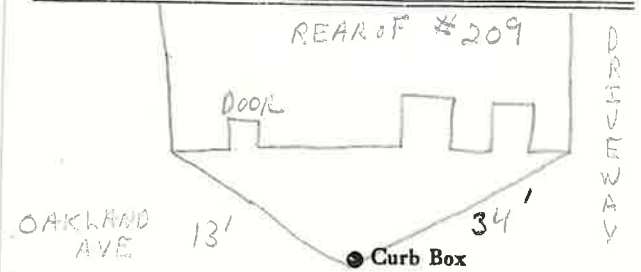

OAKLAND AVE

8" C.I. Main

Elev. of Main at tap 4'

Gate at ●

● Gate at

● Curb Box

