

32-23
Labor and Material Report *City* 21 1932

126-128 Warren St.



10 Main Elev. of Main at tap 4 1/2

Gate at ● 7' to main ● Gate at

● Curb Box


old house
no connection in
str.

SHUT OFF AT
CURB - 1996

WARREN St. No. 210-12

Name of Owner STEVENS

Labor and Mat'l. Report 1996

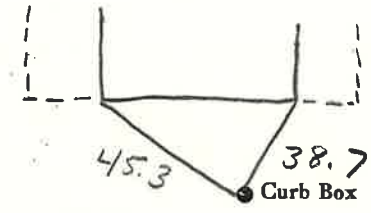

210 - TAX ID # 303.18-12-18

Main Elev. of Main at tap

Gate at ● Gate at

7' to main

● Curb Box

NOTE: TWO SERVICES
AT THIS ADDRESS - BOTH
3/4"

Labor and Materials

Copper } Connection.....	3	\$ 2.60
Lead } Connection.....		
Curb { Cock Valve T.S.&V. }in	3	\$ 2.27
Service Box { Short 3 1/2 x 4 1/2 Long 4 1/2 x 5 1/2 } Old returned { Buff. or Rdwe. }		\$ 1.38
7 Ft. } in { Copper Galv. Iron Cast Iron } Pipe at		\$ 1.26
Nipplesin. at		\$
Bushingstoin. at		\$
Red'g } Inc'g } Couplings.....to.....in.at		\$
Union.....in. at		\$
Meter.....in. at		\$
Lbs. Br. Stone at		\$
Lbs. Sand at		\$
Bags Cement at		\$
Paving Brick { Mack Red Asphalt } at		\$
Lead Joints at		\$
Leadite Joints at		\$
4 Hrs. Foreman at		\$ 2.50
2 Hrs. Common Labor at Tapper		\$ 1.00
12 Hrs. Common Labor at		\$ 5.40
Hrs. Mason at		\$
Hrs. Masons Helper at		\$
2 Hrs. Compressor at 8 1/2		\$ 17.50
Compensation Ins		\$ 2.70
Trucking		\$ 1.00
Builders Use of Water Patch		\$ 9.00
Total		\$ 28.43

LABOR AND MATERIALS

Copper } Connection		\$
Lead } Connection		\$
Curb { Cock Valve T. S. & V. }in.		\$
Service box { Short 3 1/2 x 4 1/2 } Old returned { Long 4 1/2 x 5 1/2 }		\$
3/4 Ft. } in { Copper G. I. C. I. } Pipe at		\$
Nipplesin. at		\$
Bushingstoin. at		\$
Red'g } Inc'g } Coupl'gs.....toin. at		\$
Unionin. at		\$
Meter.....in. at		\$
Compound Joints at		\$
Maintenance Foreman		\$
Hrs. Water Maint. Man-1 at		\$
Hrs. Water Maint. Man-2 at		\$
Hrs. Garage Foremanat		\$
Hrs. Labor-at		\$
Hrs. Compressor at		\$
Trucking		\$
Pav't Patch		\$
		\$
		\$
